



T.16S.R.4W.W.M.

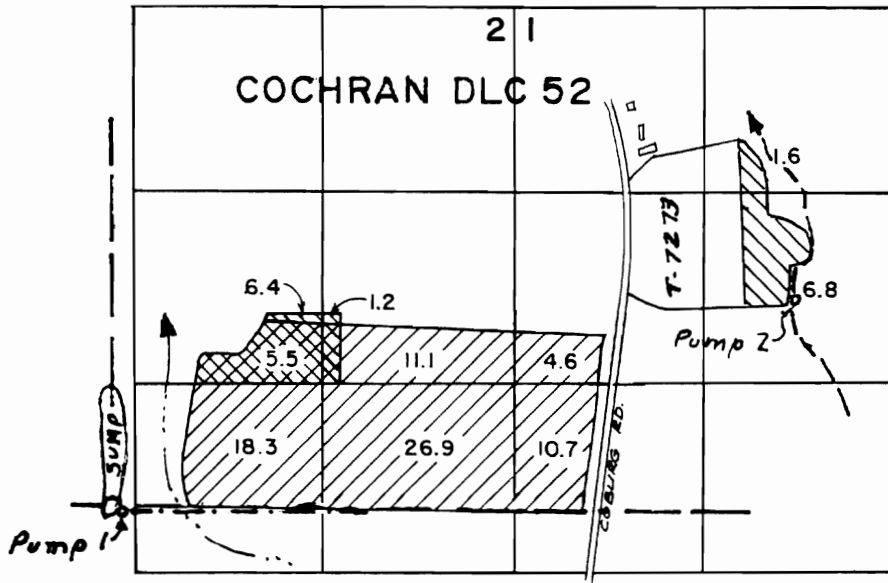

FROM  
TO

T.16S. R.3W.W.M.

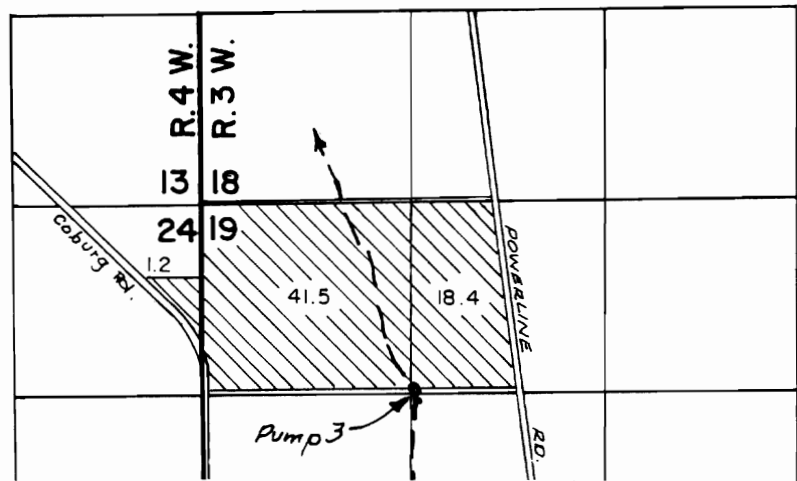


**FINAL PROOF SURVEY**  
UNDER

TRANSFER NO. T-7230  
Application No. .... Permit No. ....  
IN NAME OF

HAYWORTH FARMS, INC.

Surveyed Aug. 15, 2000, by .....

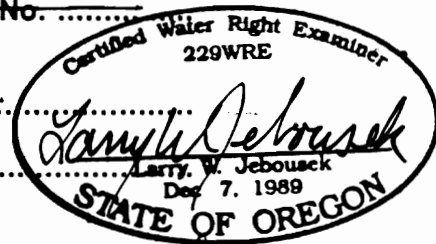

THIS MAP WAS PREPARED FOR THE PURPOSE OF IDENTIFYING THE LOCATION OF A WATER RIGHT ONLY AND IS NOT INTENDED TO PROVIDE LEGAL DIMENSIONS OR LOCATION OF PROPERTY OWNERSHIP LINES.

WAC-940R 7-16&6-225