


T. 16S. R. 4W. W.M.

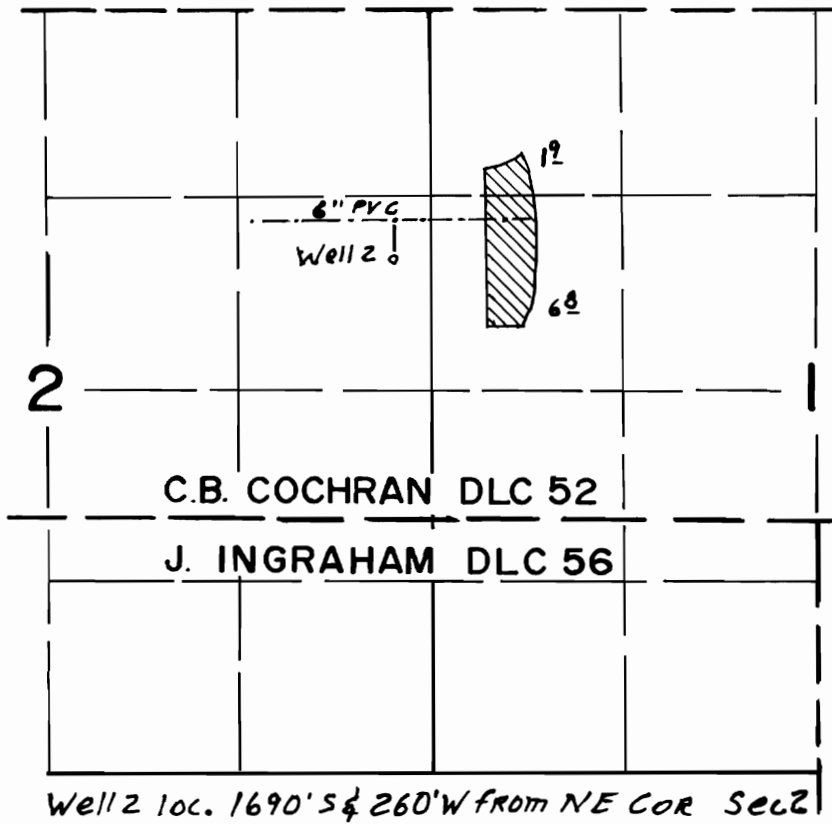


FINAL PROOF SURVEY
UNDER

TRANSFER NO. T-7231

Application No. Permit No.
IN NAME OF

HAYWORTH FARMS, INC.

Surveyed JUNE 9, 1999, by

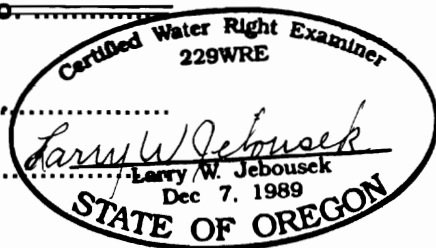

THIS MAP WAS PREPARED FOR THE PURPOSE OF IDENTIFYING THE LOCATION OF A WATER RIGHT ONLY AND IS NOT INTENDED TO PROVIDE LEGAL DIMENSIONS OR LOCATION OF PROPERTY OWNERSHIP LINES.