


T6S R7W WM

SALMON

RIVER

Scale: 1" = 400'

HIGHWAY

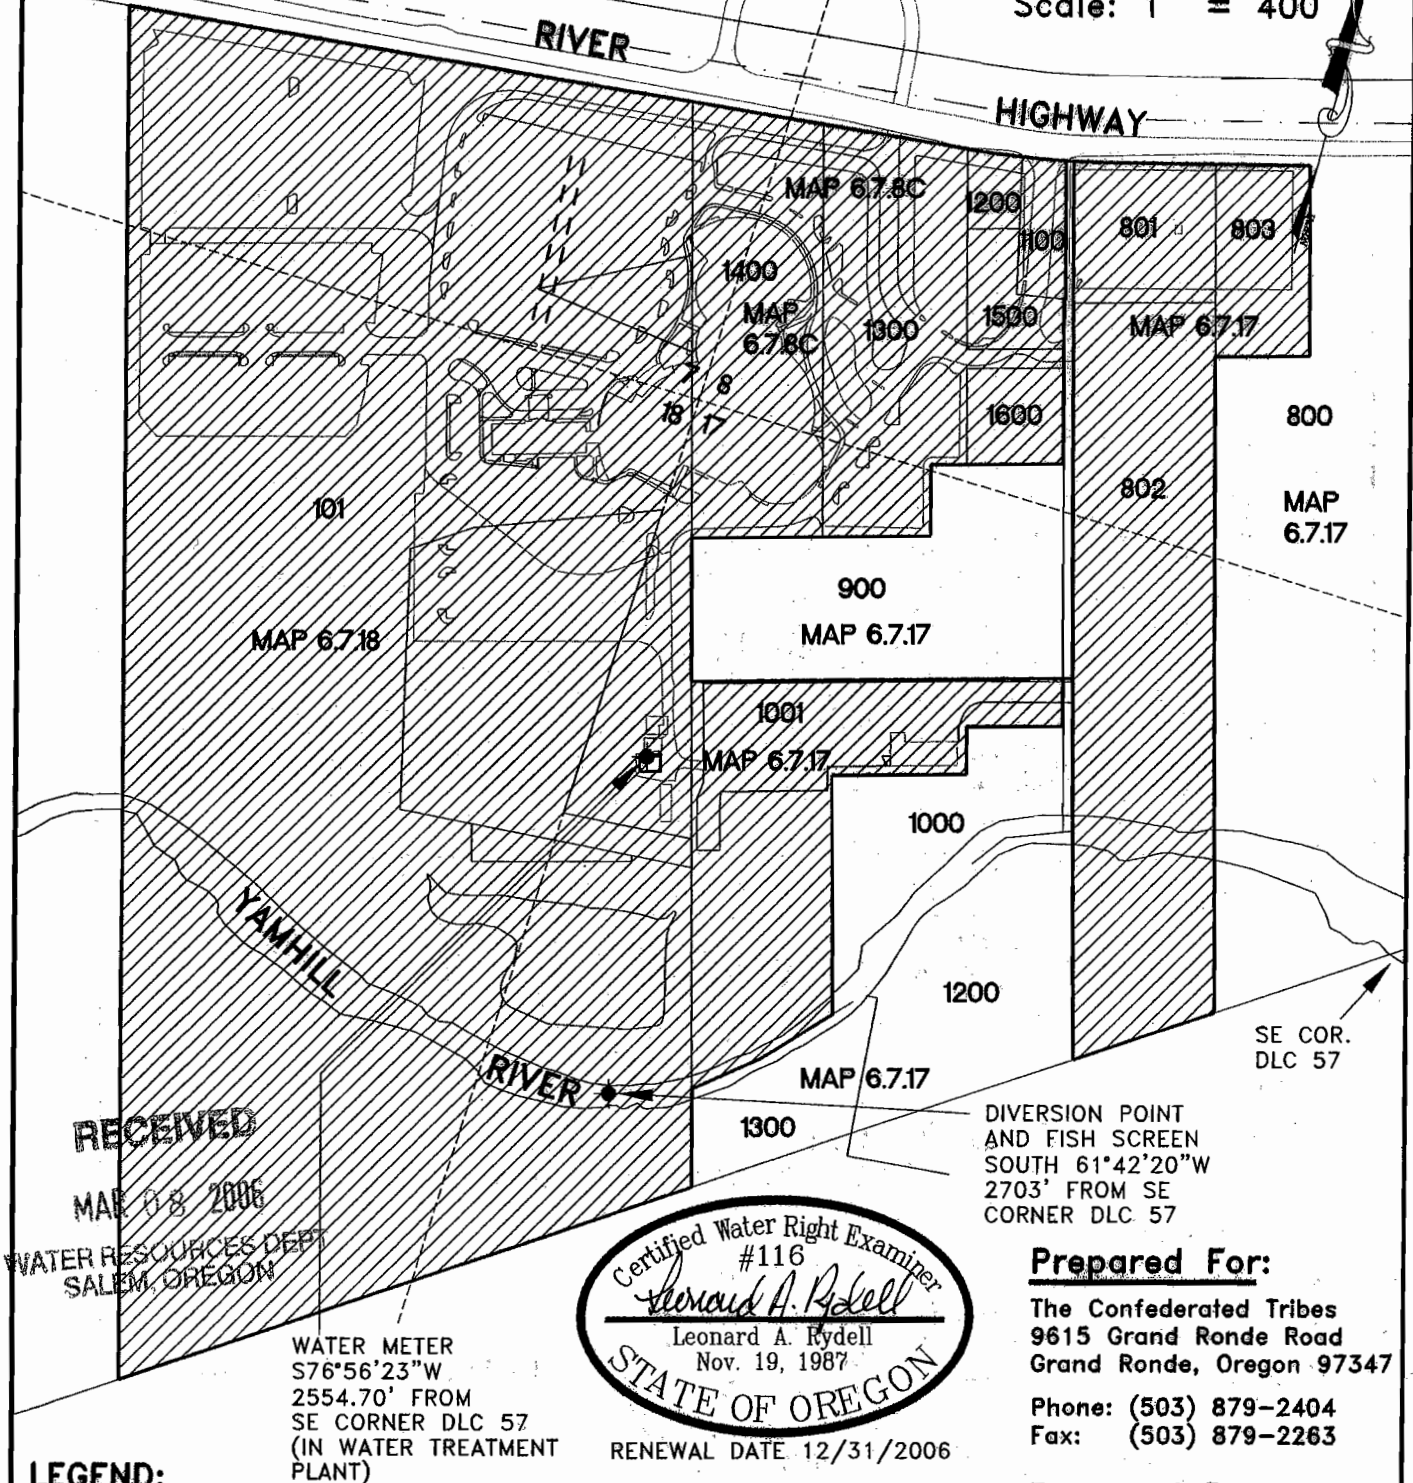


RECEIVED

MAR 08 2006

WATER RESOURCES DEPT
SALEM, OREGON

WATER METER
S76°56'23\"W
2554.70' FROM
SE CORNER DLC 57
(IN WATER TREATMENT
PLANT)

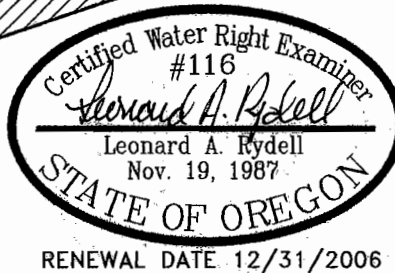

LEGEND:



Tribal Property-Point of Primary Use

NOTE:

This map was prepared for the purposes of identifying the location of the water right only and is not intended to provide legal dimensions or locations of property ownership lines.

Prepared For:

The Confederated Tribes
9615 Grand Ronde Road
Grand Ronde, Oregon 97347

Phone: (503) 879-2404
Fax: (503) 879-2263


Prepared By:

Leonard A. Rydell, W.R.E.
601 Pinehurst Drive
Newberg, Oregon 97132

Phone: (503) 538-5700
Fax: (503) 538-9167

DWG: QMU-CBU.DWG

QUASI-MUNICIPAL CLAIM OF BENEFICIAL USE MAP

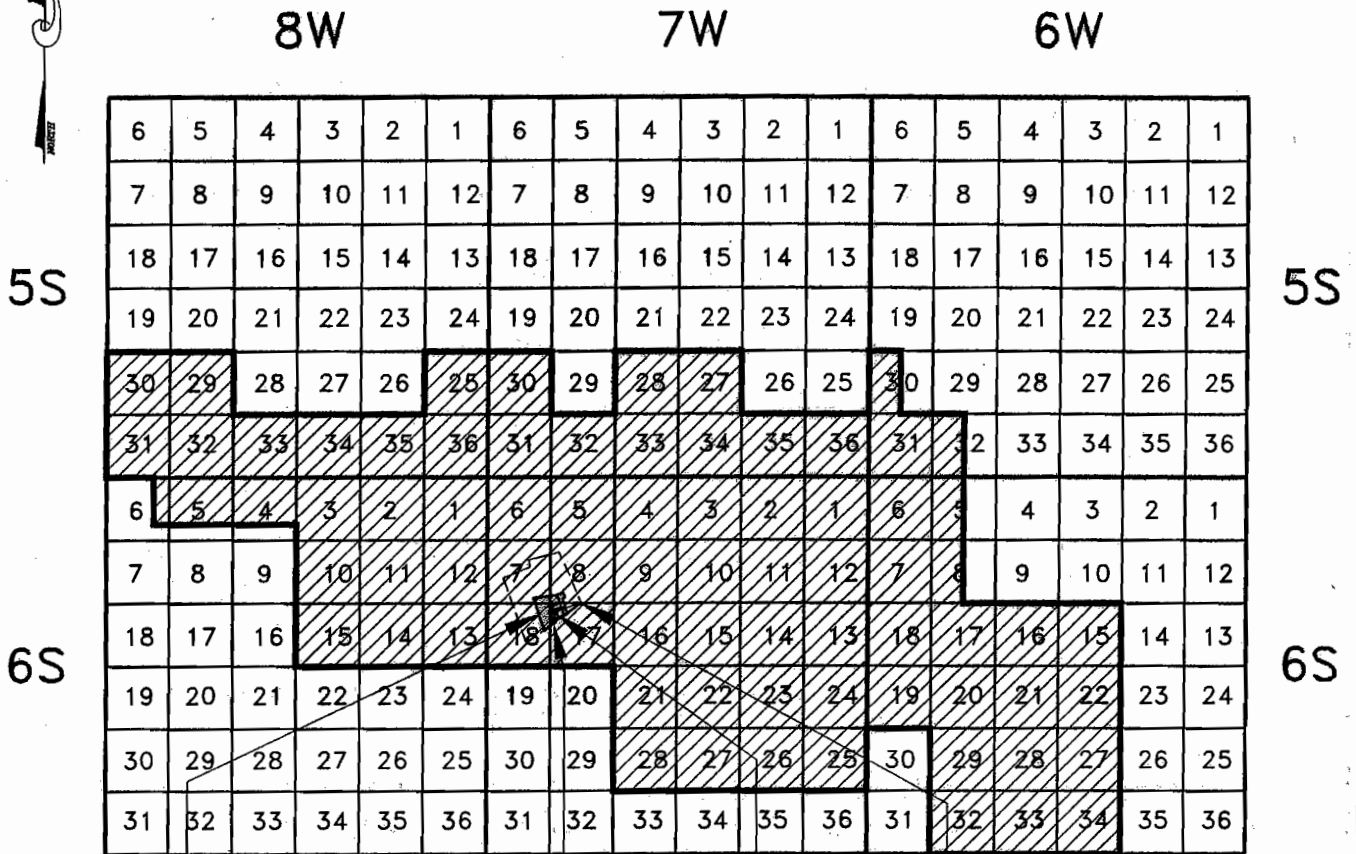

PRIMARY
PLACE OF
USE

8W

DIVERSION POINT
AND FISH SCREEN
S61°42'20"W
2703' FROM SE
CORNER DLC 57

7W

WATER METER
S76°56'23"W
2554.70' FROM
SE CORNER DLC
57 (IN WATER
TREATMENT PLANT)

SE COR
DLC 57

6W


RECEIVED

MAR 08 2006

SERVICE AREA 47,160 ACRES BASED
ON 640 ACRES PER SQUARE MILE

WATER RESOURCES DEPT
SALEM, OREGON

Scale: 1" = 16,000'

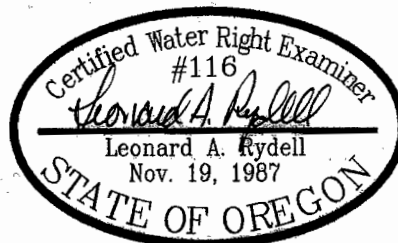

RENEWAL DATE 12/31/2006

NOTE:

This map was prepared for the purposes of identifying the location of the water right only and is not intended to provide legal dimensions or locations of property ownership lines.

Prepared For:

The Confederated Tribes
9615 Grand Ronde Road
Grand Ronde, Oregon 97347

Phone: (503) 879-2404
Fax: (503) 879-2263

Prepared By:

Leonard A. Rydell, W.R.E.
601 Pinehurst Drive
Newberg, Oregon 97132

Phone: (503) 538-5700
Fax: (503) 538-9167

DWG: QUASI-MPL-CBO.DWG