


# T. 26 S., R. 17 E., W. M.

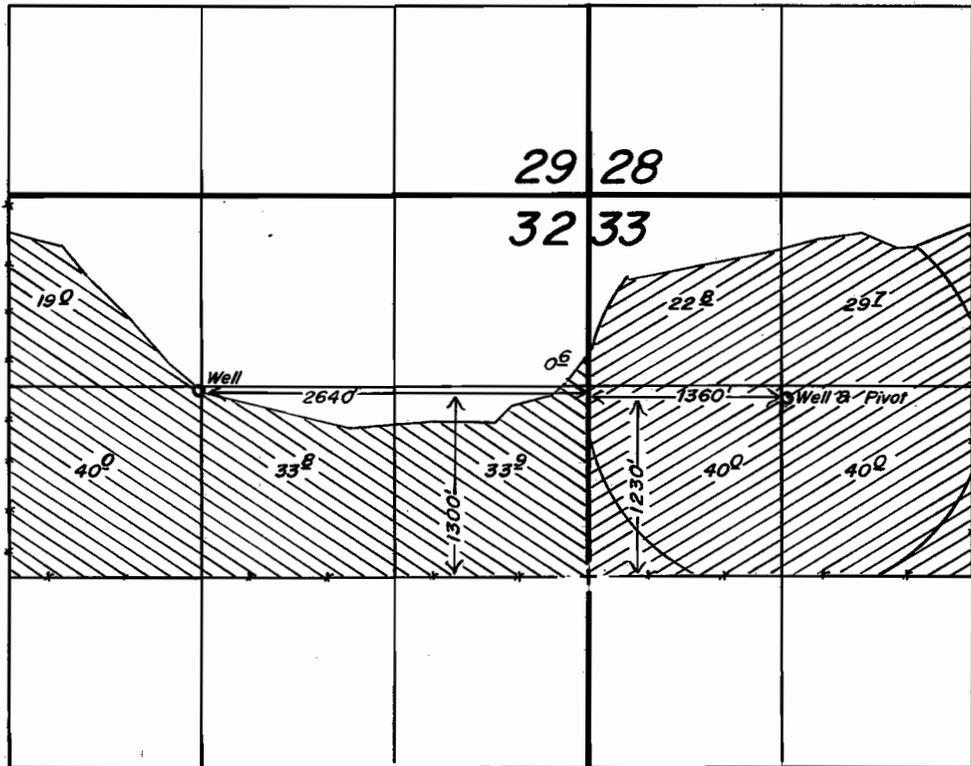

Scale: 1" = 1320'

## FINAL PROOF SURVEY UNDER

Application No. G-9818 Permit No. G-9063  
G-9822 G-9067

IN NAME OF


**GOLDEN RULE FARMS**

Surveyed Oct. 22, 1984, by Leslie Olson

# MAP TO ACCOMPANY APPLICATION TO TRANSFER WATER RIGHTS CHANGE POINT OF APPROPRIATION AND TO ESTABLISH ADDITIONAL POINT OF APPROPRIATION FOR GOLDEN RULE FARMS, INC.

## EXISTING WATER RIGHTS TO REMAIN AND BE TRANSFERRED AND POINTS OF APPROPRIATION

LOCATED IN THE NW1/4 OF SECTION 33  
AND IN THE N1/2 OF SECTION 32  
TOWNSHIP 26 SOUTH, RANGE 17 EAST, W.M.  
LAKE COUNTY, OREGON

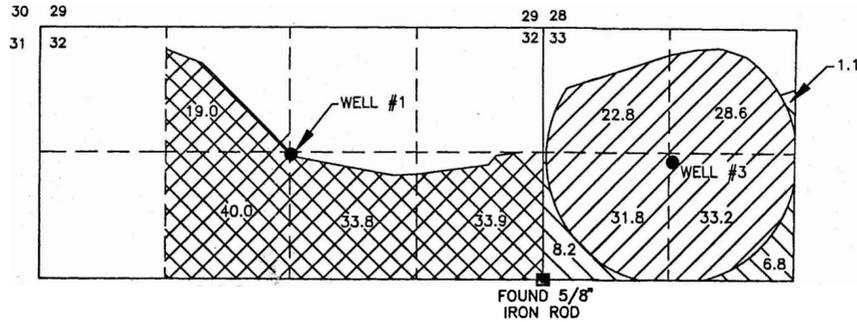

### EXISTING POINTS OF APPROPRIATION

WELL #1: CERTIFICATE #53350,  
LOCATED IN THE SE1/4 OF THE NW1/4 OF  
SECTION 32; 1300 FEET NORTH AND 2640  
FEET WEST FROM THE EAST 1/4 CORNER OF  
SECTION 32.


WELL #3: CERTIFICATE #53349,  
LOCATED IN THE SE1/4 OF THE NW1/4 OF  
SECTION 33; 1300 FEET NORTH AND 1360  
FEET WEST FROM THE WEST 1/4 CORNER OF  
SECTION 33.

### LEGEND

- 116.4 ACRES AS PER CERTIFICATE #53349  
TO REMAIN IN PLACE.
- 1.1 ACRES AS PER CERTIFICATE #53349  
TO BE TRANSFERRED AS SHOWN.
- 1.1 ACRES AS PER CERTIFICATE #53350  
TO BE TRANSFERRED AS SHOWN.

## EXISTING WATER RIGHTS TO REMAIN AND BE TRANSFERRED AND POINT OF APPROPRIATION

LOCATED IN THE SE1/4 OF SECTION 2  
TOWNSHIP 28 SOUTH, RANGE 16 EAST, W.M.  
LAKE COUNTY, OREGON

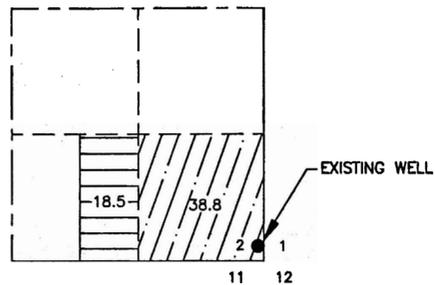

### LEGEND


- 38.8 ACRES AS PER CERTIFICATE #77737  
TO REMAIN IN PLACE.
- 18.5 ACRES AS PER CERTIFICATE #77737  
TO BE TRANSFERRED AS SHOWN.

### EXISTING POINT OF APPROPRIATION

WELL: CERTIFICATE #77737,  
LOCATED IN THE SE1/4 OF THE SE1/4 OF  
SECTION 2; 160 FEET NORTH AND 60  
FEET WEST FROM THE SE CORNER OF  
SECTION 2.

## CONFIGURATION AFTER TRANSFER

LOCATED IN THE NW1/4 OF SECTION 33  
AND IN THE N1/2 OF SECTION 32  
TOWNSHIP 26 SOUTH, RANGE 17 EAST, W.M.  
LAKE COUNTY, OREGON

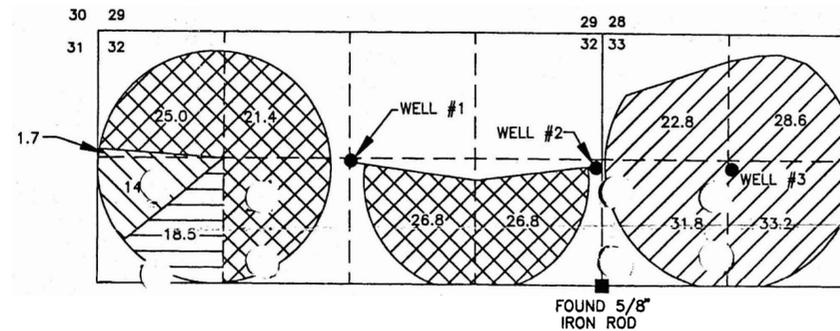

### ADDITIONAL POINT OF APPROPRIATION

WELL #2: ADDITIONAL POINT OF APPROPRIATION,  
LOCATED IN THE SE1/4 OF THE NE1/4 OF  
SECTION 32; 1242 FEET NORTH AND 63  
FEET WEST FROM THE WEST 1/4 CORNER OF  
SECTION 33.

### POINT OF APPROPRIATION CHANGES

MOVE WELL #3 TO WELL #1 AND WELL #2  
FOR 16.1 ACRES



RECEIVED

MAR 07 2002

WATER RESOURCES DEPT.  
SALEM, OREGON

SCALE 1" = 1320'

THIS MAP IS FOR THE PURPOSE OF LOCATING A  
WATER RIGHT ONLY AND HAS NO INTENT TO PROVIDE  
LEGAL DIMENSIONS OR THE LOCATION OF  
PROPERTY LINES.

PREPARED FOR:  
GOLDEN RULE FARMS, INC.  
P.O. BOX 137  
CHRISTMAS VALLEY, OR 97641

PREPARED BY:  
CALLAGHAN LAND SURVEYING  
**CLS** 427 SOUTH H STREET  
LAKEVIEW, OR 97630  
(541) 947-5841

DATE: 3/3/2002

DRAWING: 200101F

RECEIVED

MAR 25 2004

WATER RESOURCES DEPT.  
SALEM, OREGON

T-9057