

RECEIVED

MAR 14 2000


WATER RESOURCES DEPT.
SALEM OREGON

T.40S.,R.9W.,W.M.
SECTION 25

FINAL PROOF SURVEY
UNDER

TRANSFER NO. T-7257 MODIFYING CERTIFICATE NO. 14192
IN THE NAME OF
ROBERT J. NICOLAW


SURVEYED FEB. 18, 2000 BY JONATHAN C. SPERO

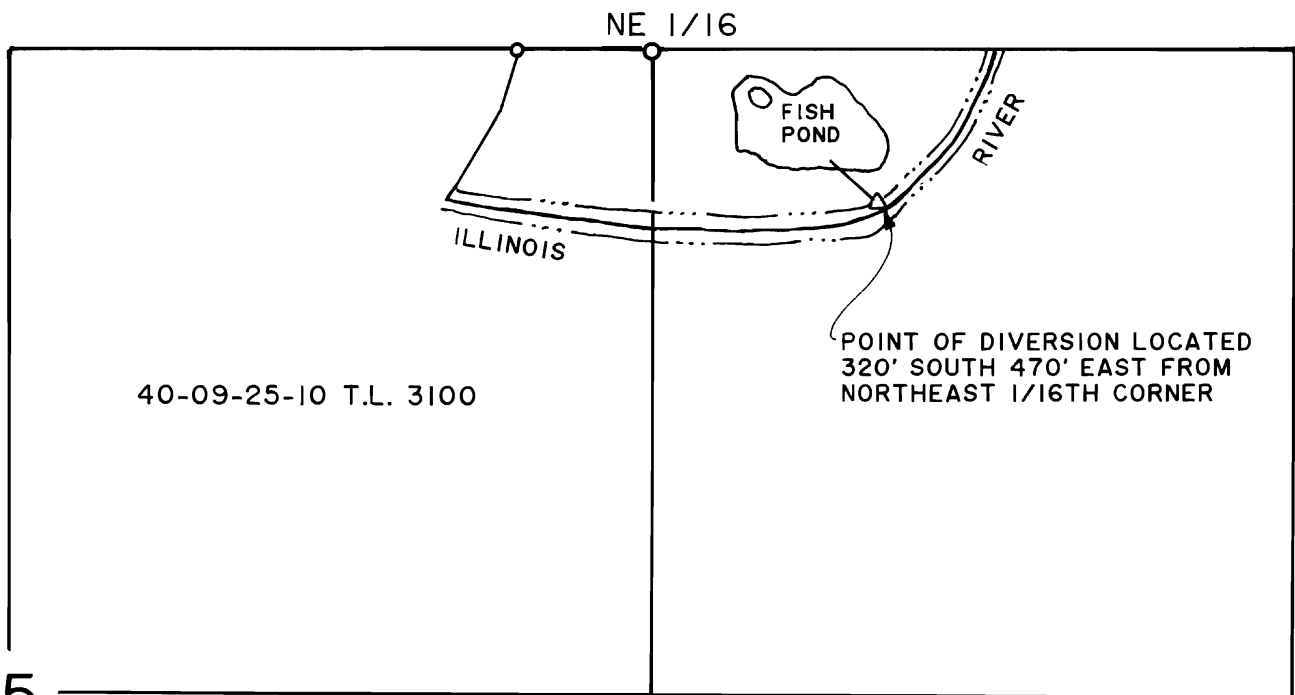

25

PREPARED BY:
JONATHAN C. SPERO C.W.R.E. 123
1002 KINCAID RD./P.O. BOX 16
WILLIAMS, OREGON 97544
PH. (541) 846-6845

THIS MAP IS FOR THE PURPOSE OF
IDENTIFYING THE LOCATION OF THE
WATER RIGHT ONLY, AND IS NOT IN-
TENDED TO PROVIDE LEGAL DIMEN-
SIONS OR LOCATIONS OF PROPERTY
OWNERSHIP LINES.

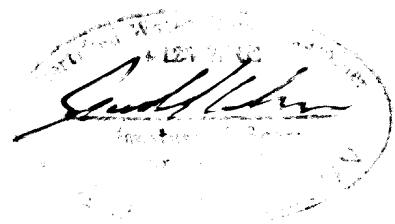

LICENSE RENEWAL DATE:
JUNE 30, 2000

SCALE: 1" = 400'