
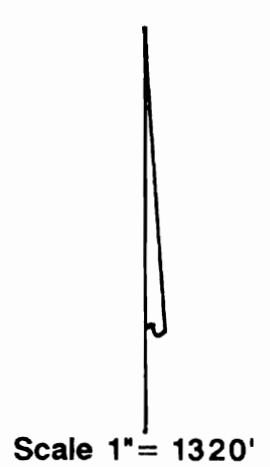


RECEIVED

FEB 14 1997

WATER RESOURCES DEPT
SALEM, OREGON

T.6S., R.1W., W.M.

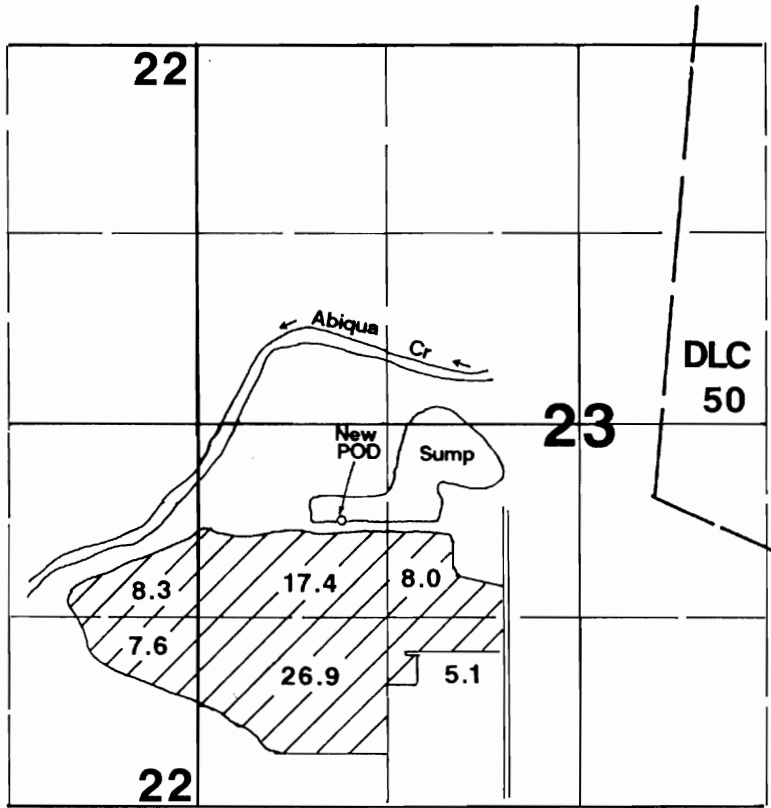

New POD located 2000'N & 1000'E from SW corner Section 23.

Final Proof Survey

Transfer #: T-7279

In Name Of

Pembroke Farms

Surveyed on February 6, 1997 by JM Schuette

THIS MAP WAS PREPARED FOR THE PURPOSE OF IDENTIFYING THE LOCATION OF A WATER RIGHT ONLY AND IS NOT INTENDED TO PROVIDE LEGAL DIMENSIONS OR LOCATION OF PROPERTY OWNERSHIP LINES.

