


TOWNSHIP 2 SOUTH, RANGE 3 EAST, W.M.

Placed in file
for reference

8/10/04

ASP

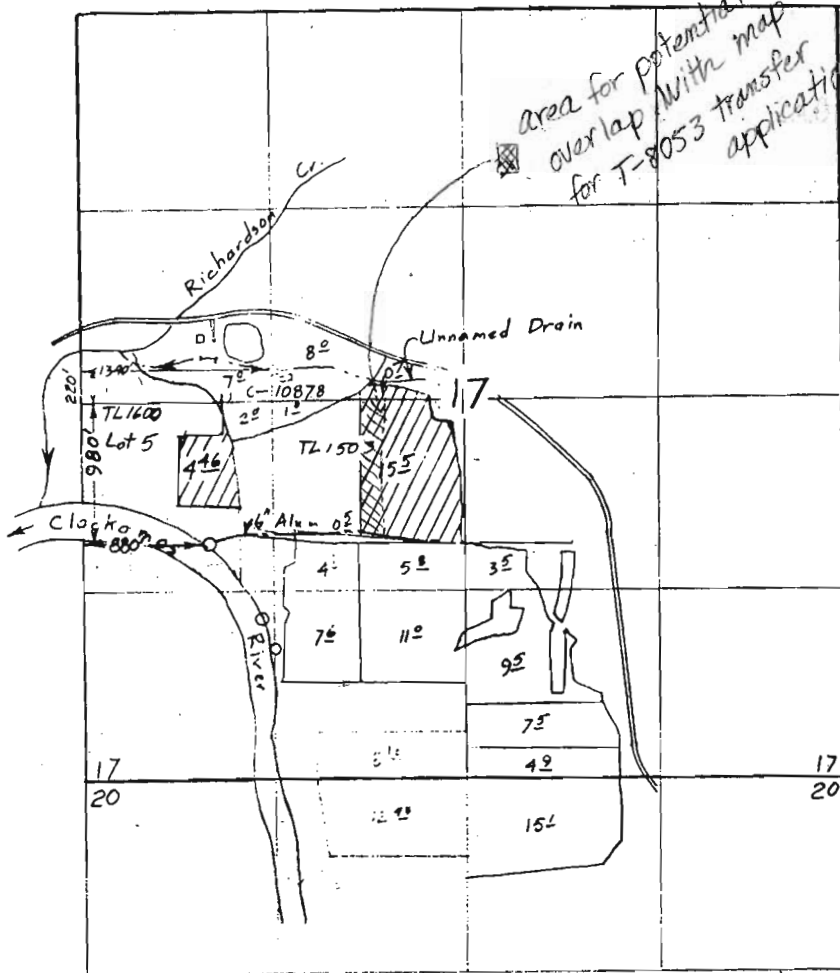


Scale 1" = 1320'

Surveyed Sep 18, 2000 .

T-7676

Claim of Beneficial Use Map
for
JIM CALCAGNO

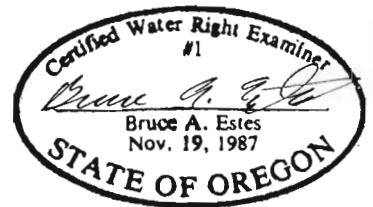

This map is for the purpose of
locating a water right only
and has no intent to provide
legal dimensions or the location
of property lines.

ESTES SURVEYS

6293 Sunnyview Rd. NE 60382 Arnold Rd.
Salem, OR 97305 Bend, OR 97702
(503) 585-7593 (503) 382-7391