


MAP TO ACCOMPANY APPLICATION FOR
TRANSFER OF WATER RIGHT

- ⑤ New Cranston POD transfer from old POD
880 ft E of $W\frac{1}{2}$ corner Sec. 17, in $SW\frac{1}{2}NW\frac{1}{2}$ of Sec. 17.
- ⑦ Old Cranston POD
880 ft E and 700 ft N of $W\frac{1}{2}$ corner Sec. 17, in $SW\frac{1}{2}NW\frac{1}{2}$ Sec. 17.
- ⑥ New Perkins POD (Additional POD)
50 ft S and 800 ft E from $W\frac{1}{2}$ corner Sec. 17, in $NW\frac{1}{2}SW\frac{1}{2}$ Sec. 17.
- ⑧ Old Perkins POD
900 ft S and 700 ft W from NE corner Sec. 18, in $NE\frac{1}{2}NE\frac{1}{2}$ Sec. 18.

Applicant Lower Powder River Irrigation District

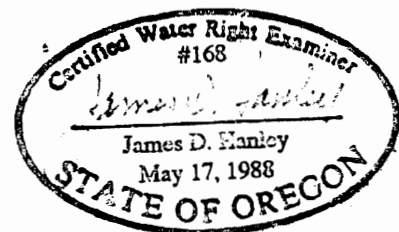

T 7287