
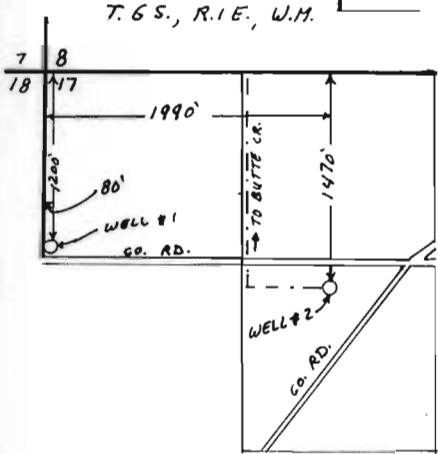
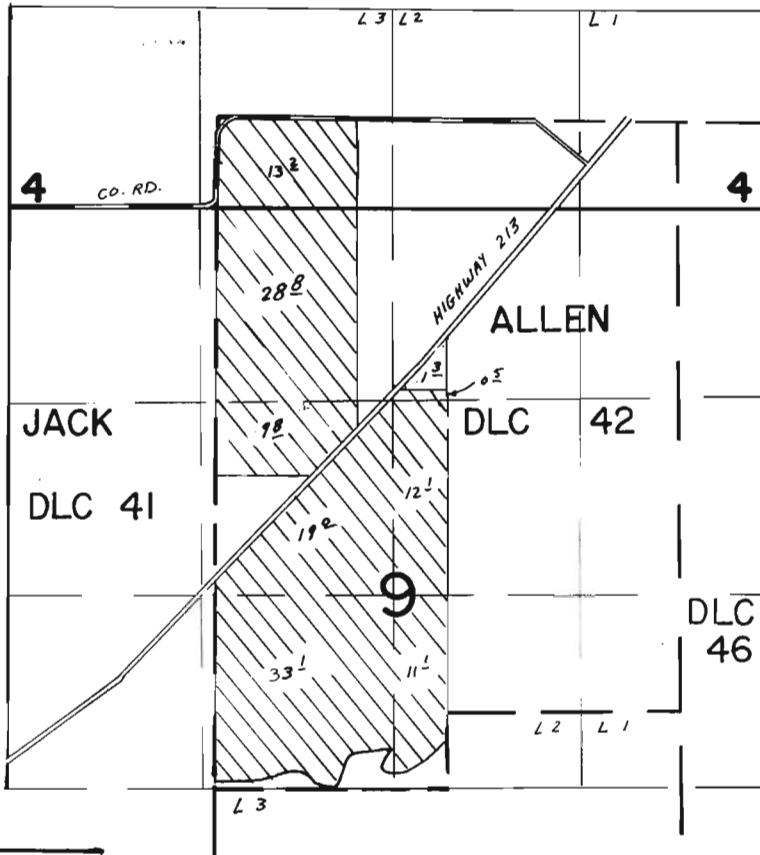


T. 6 S., R. 1 E., W. M.

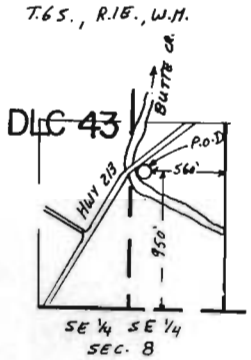

SCALE 1" = 1320'

FINAL PROOF SURVEY UNDER

Application No. G-10343 Permit No. G-10143

IN NAME OF

HAROLD KRAEMER

Surveyed JUN 6 1988, by Z. SALEH

41005-278-144c
5-17-89 Z. f. S.