


Township 6 South, Range 3 West, W.M.

RECEIVED

Portions of Sections 4, 5, 8 & 9

JAN 26 1995

WATER RESOURCES DEPT
SALEM, OREGON

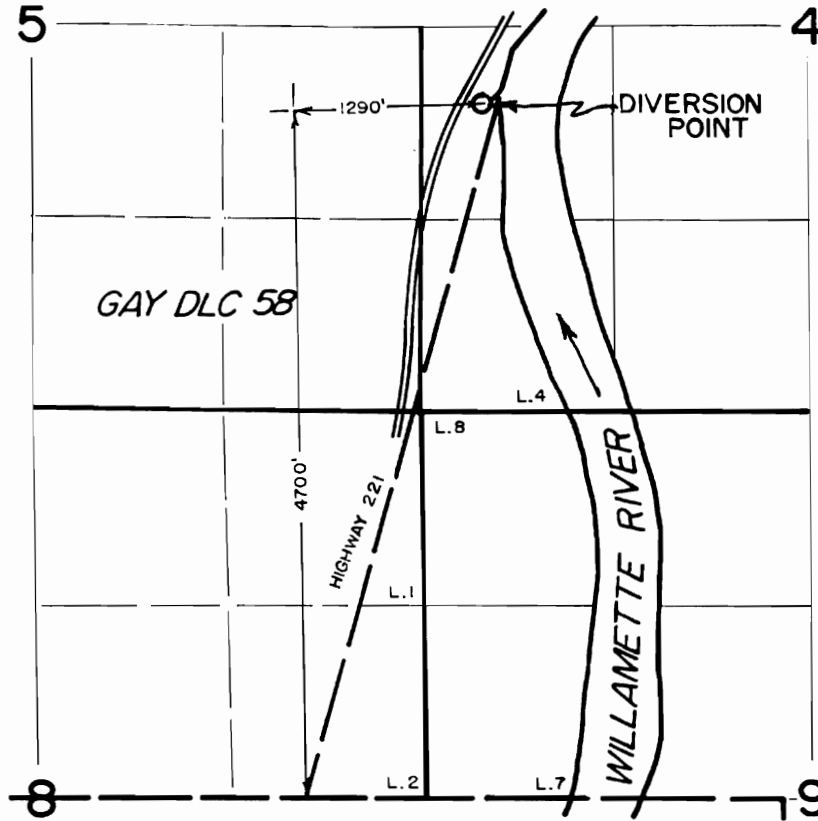

Map to Accompany
Transfer Application
in the name of
PALMER CREEK
WATER DISTRICT IMPROVEMENT COMPANY
(diversion point location)

Trans. No. T-7298



THIS MAP WAS PREPARED FOR THE PURPOSE OF IDENTIFYING THE LOCATION OF A WATER RIGHT ONLY AND IS NOT INTENDED TO PROVIDE LEGAL DIMENSIONS OR LOCATION OF PROPERTY OWNERSHIP LINES.