


RECEIVED


WATER RESOURCES
DIVISION

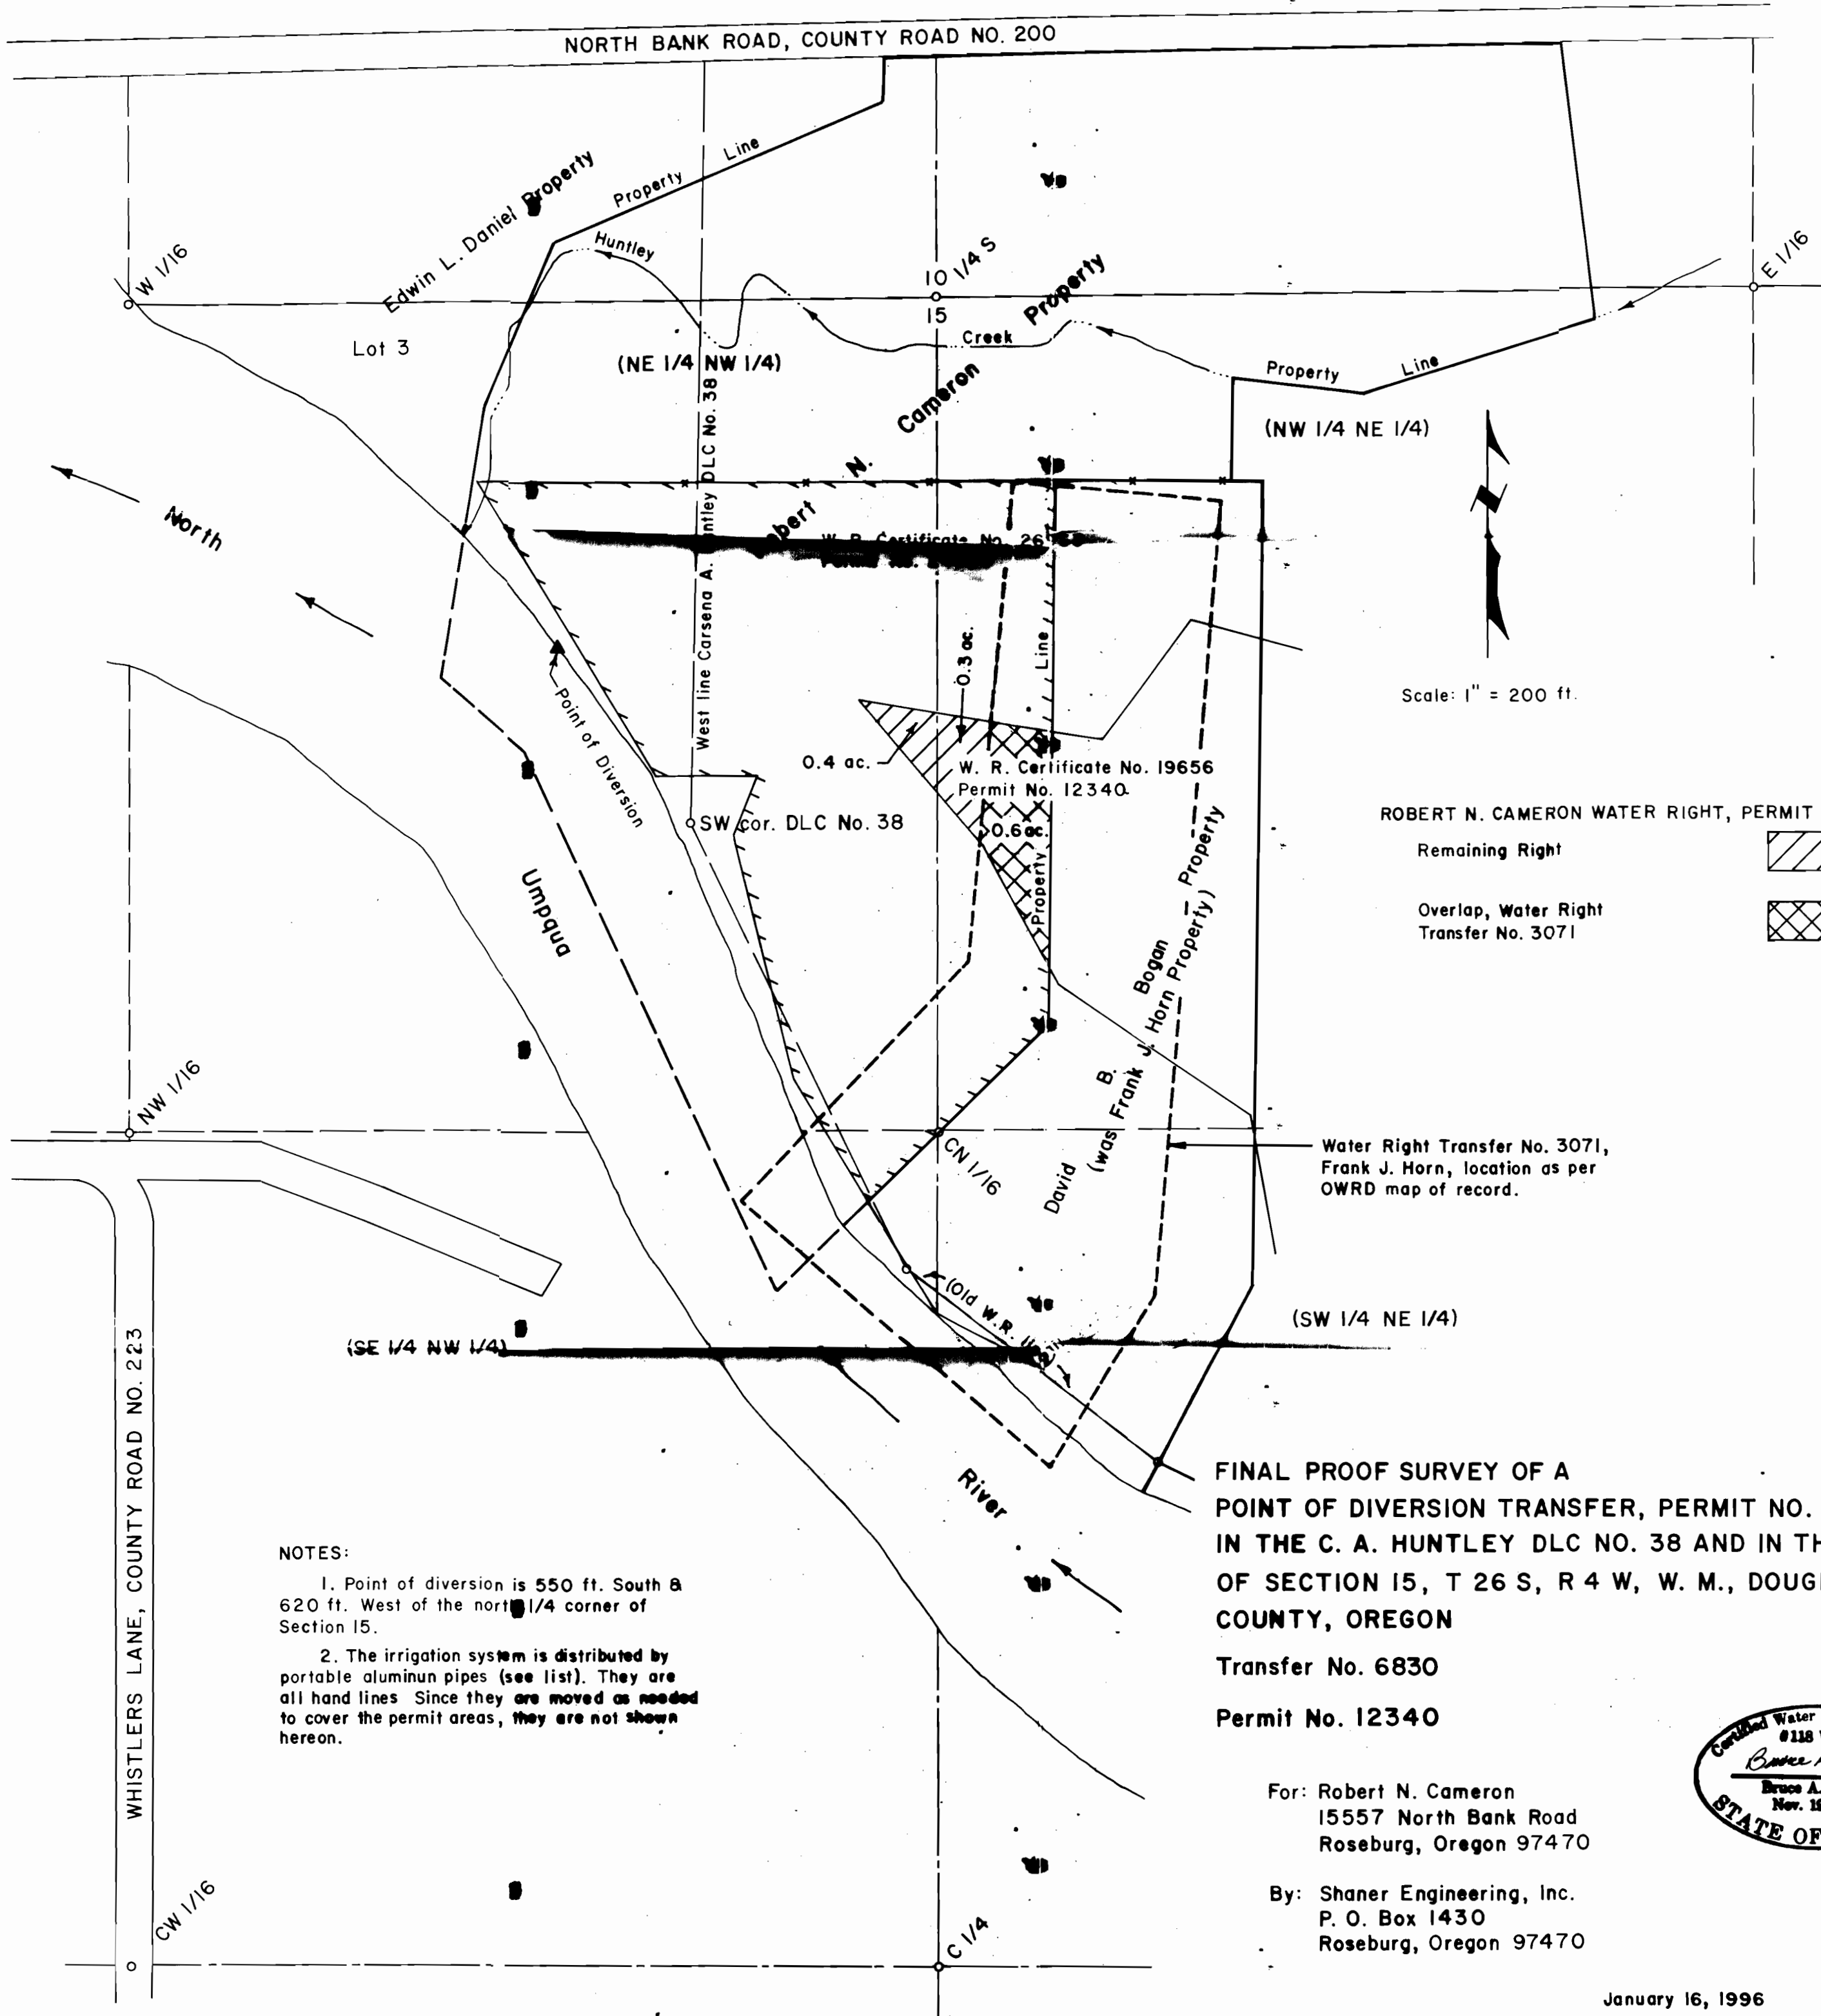

Scale: 1" = 200 ft.

ROBERT N. CAMERON WATER RIGHT, PERMIT NO. 12340

Remaining Right

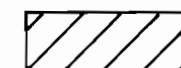

Overlap, Water Right
Transfer No. 3071



Water Right Transfer No. 3071,
Frank J. Horn, location as per
OWRD map of record.

NOTES:

1. Point of diversion is 550 ft. South & 620 ft. West of the north 1/4 corner of Section 15.
2. The irrigation system is distributed by portable aluminum pipes (see list). They are all hand lines. Since they are moved as needed to cover the permit areas, they are not shown hereon.

FINAL PROOF SURVEY OF A
POINT OF DIVERSION TRANSFER, PERMIT NO. 12340
IN THE C. A. HUNTLEY DLC NO. 38 AND IN THE N 1/2
OF SECTION 15, T 26 S, R 4 W, W. M., DOUGLAS
COUNTY, OREGON

Transfer No. 6830

Permit No. 12340

For: Robert N. Cameron
15557 North Bank Road
Roseburg, Oregon 97470

By: Shaner Engineering, Inc.
P. O. Box 1430
Roseburg, Oregon 97470



January 16, 1996