

(CS 2526)

21.283 ch = 1404.68 Bolt to stone (S 89° 17' W per CS 1121)
N 89° 36' E S 89° 36' W

Map of Beneficial Use

Under

APPLICATION T-6885

in the name of

MELVIN and LAVERNA COUEY

36483 Hwy. 226

Albany, OR 97321

Date of Site Inspection: July 29, 1998

Date of Map: September 21, 1998

Tax Lot: 1301 (11-2W-9)

Source: A well, a tributary of the Santiam River Basin


Area of Irrigation

Under T-6885, there are 4.49 acres being put to beneficial use as specified by quarter-quarter sections on the herein attached map.

I, JACK R. BURRELL, BEING DULY SWORN AS A WATER RIGHT EXAMINER, LICENSE NO. 209, HAVE PREPARED THIS MAP FOR MELVIN AND LAVERNA COUEY ON THIS 21ST DAY OF SEPTEMBER 21, 1998. THE AREAS HATCHED REPRESENT THE ACREAGE'S BEING IRRIGATE AT THE TIME OF THE SITE INSPECTION CONDUCTED ON JULY 29, 1998.

PREPARATION OF THIS MAP IS FOR THE PURPOSE OF IDENTIFYING THE LOCATION OF THE WATER RIGHT ONLY AND HAS NO INTENT TO PROVIDE DIMENSIONS OR LOCATION OF PROPERTY OWNERSHIP LINES.

LEGEND:

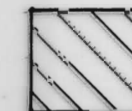

Area under irrigation. Total 4.49 acres

NW 1/4 NW 1/4 Sec 9

SW 1/4 NW 1/4 Sec 9

Well No. 2 (Secondary P.O.D.)

Well No. 3 (Primary P.O.D.)

T.L. 1401 Land owned by Permittee being irrigated under Permit 6-12252

NE 1/4 NW 1/4

SE 1/4 NW 1/4 Sec 9

SCALE: 1" = 200' ±



NON-IRRIGATED SWALE

RESIDENCE

Ludlow Maxwell DLC 43 Walter Ketchum DLC 42

POT 14+00

N 89° 18' E

N 85° 01' W 305.5

353.76

N 89° 51' W

4° CR Δ = 18° 54' T = 238.4 L = 472.5

409.2 (Neat per CS 1121)

P.T. 31+26.8


N 87° 40' E

330.0' per CS 1121

RECEIVED

SEP 25 1998

WATER RESOURCES DEPT. SALEM, OREGON

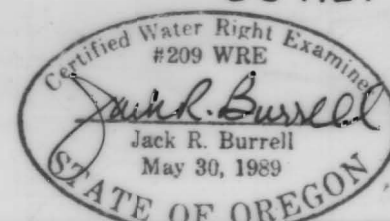

EXPIRATION DATE: 12/31/98

KD ENGINEERING, INC.
802 NW HICKORY STREET
POST OFFICE BOX 725
ALBANY, OREGON 97321

COUEY WATER RIGHT

LOCATED IN SEC. 9, T. 11 S., R. 2 W., W.M., LINN COUNTY, OR.

DSGN. BY: N/A.	SCALE: 1" = 200'
DWG. BY: M.M.S.	DATE: Sept 21, 1998
CHKD. BY: J.R.B.	PROJECT NO: 92-143

SHEET NO.

1