

Scale: 1" = 200 ft.

- POINT OF DIVERSION
1. 1,240 ft. North & 490 ft. West of the south 1/4 corner of Section 4
 2. 670 ft. North & 370 ft. West of the south 1/4 corner of Section 4


Note:
The POD's remain in same position on ground as originally located, but are now tied to a much closer South 1/4 Corner, Section 4.

POINT OF DIVERSION & USE TRANSFERS, PERMITS NO. R-5034 & 32750, in the S 1/2 of Section 4, T 22 S, R 5 W, W. M., Douglas County, Oregon

Application No's. R-43741 & 43742
Permit No's. R-5034 & 32750

For: Woolley Enterprises, Inc.
P. O. Box 578
Drain, Oregon 97435

By: Shaner Engineering, Inc.
P. O. Box 1430
Roseburg, Oregon 97470

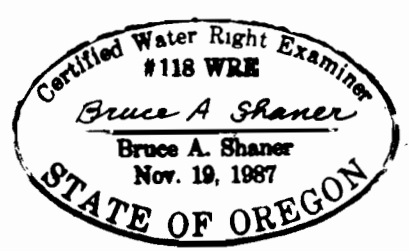

February 22, 1993