


SECTIONS 16 & 17, TWP.2 N. RANGE 13 E. W.M.  
 WASCO COUNTY, OREGON

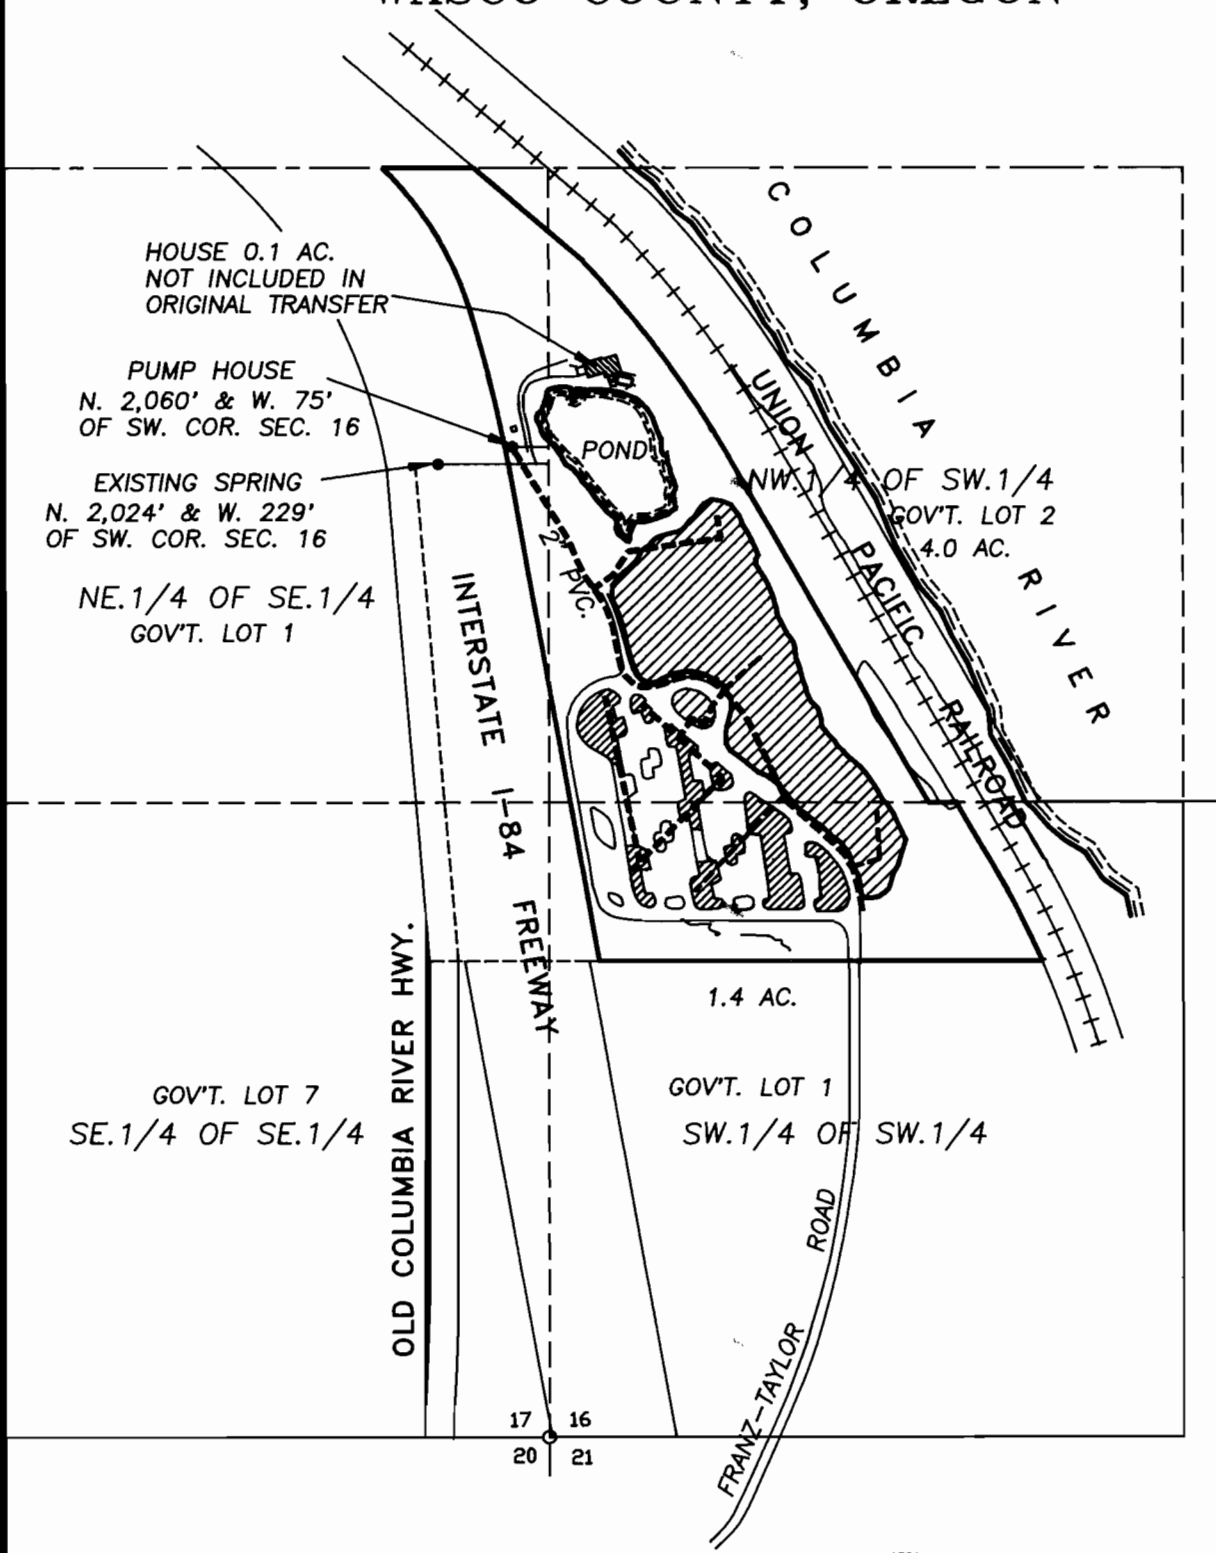

**WATER RIGHT**  
**FINAL PROOF SURVEY**

SCALE: 1" = 400'


CERTIFICATE No. \_\_\_\_\_

PERMIT No. T-6975

IN THE NAME OF:  
WASCO COUNTY

DATE: SEPTEMBER 30, 1996

BY: TENNESON ENGINEERING CORP.  
 409 LINCOLN STREET,  
 THE DALLES, OREGON. 97058  
 PH. 541-296-9177  
 FAX 541-296-6657

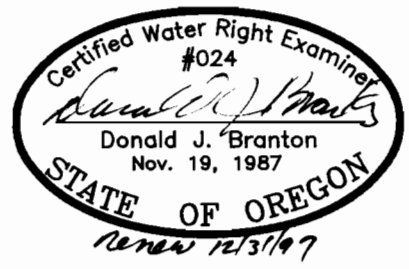

**NOTE:**  
 "THIS MAP IDENTIFIES THE LOCATION OF THE WATER RIGHT ONLY AND IS NOT INTENDED TO PROVIDE DIMENSIONS OR LOCATE PROPERTY OWNERSHIP LINES."

W.O. #8431WRT