

I. 355., R. 14W., W.M.

**RECEIVED**

AUG - 4 1992


WATER RESOURCES DEPT  
SALEM OREGON

**RECEIVED**

SEP 09 1998

WATER RESOURCES DEPT.  
SALEM, OREGON

SCALE: 1" = 400'

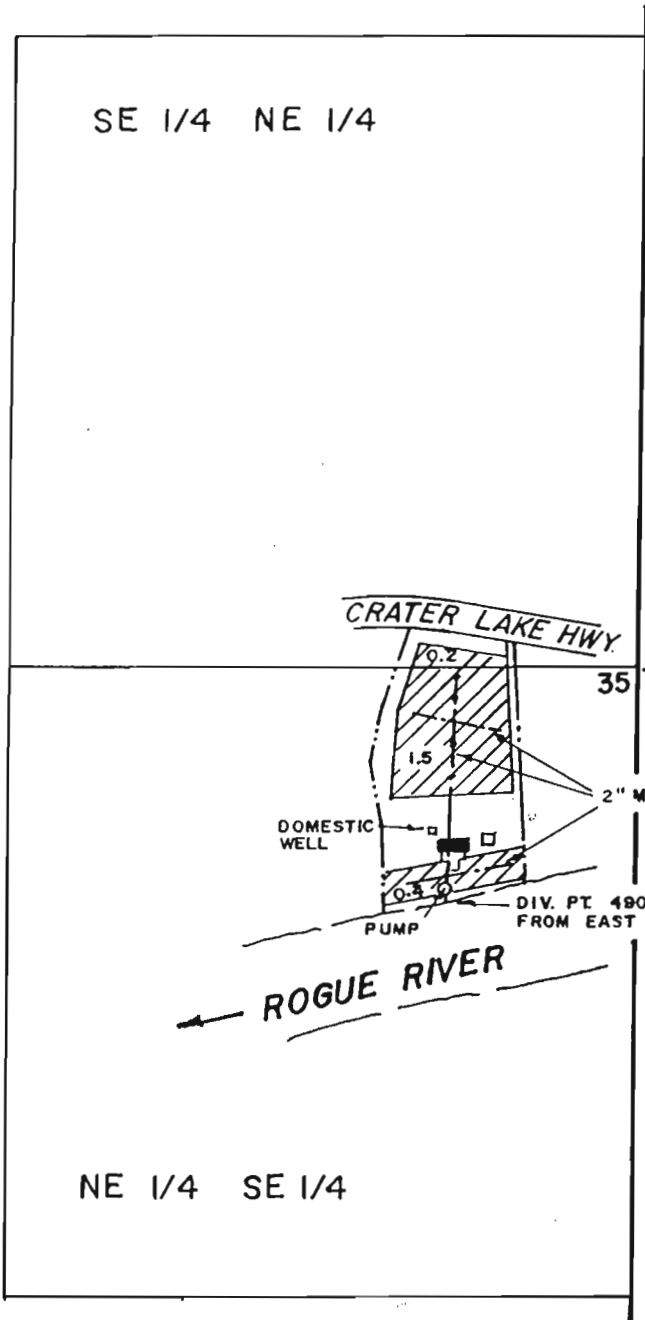

**FINAL PROOF MAP**

APPLICATION NO 69698 PERMIT NO. 50424

IN THE NAME OF

GLENN J. BARTON & JERILYNN BARTON

NOTE THIS MAP HAS BEEN PREPARED FOR WATER RIGHT PURPOSE ONLY, NOT FOR PROPERTY BOUNDARY LOCATIONS

MAP PREPARED JULY 29, 1992 BY GARY D. KAISER

