


RECEIVED

AUG 24 1998

WATER RESOURCES DEPT
SALEM, OREGON


T.3N., R. 30 E.

T.3N., R. 31 E.

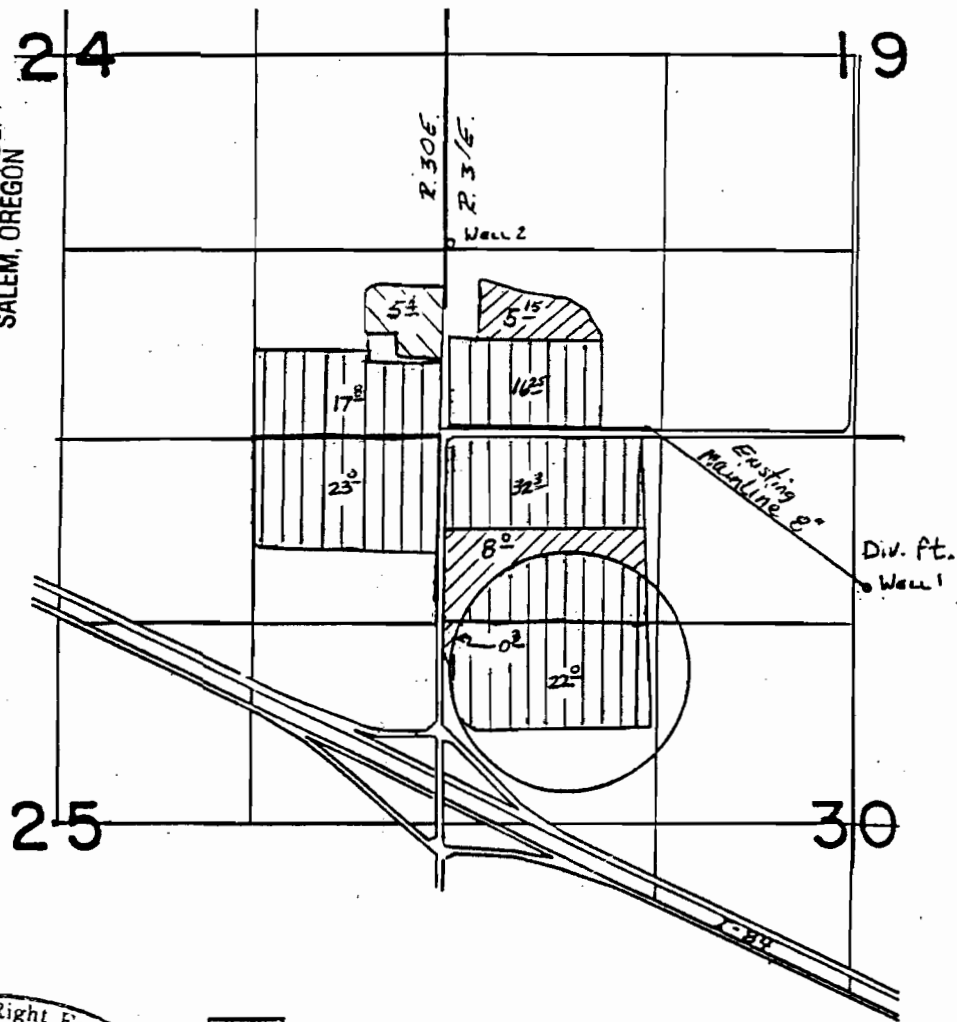

T. 3N., R. 30 E.

T. 3N., R. 31 E.

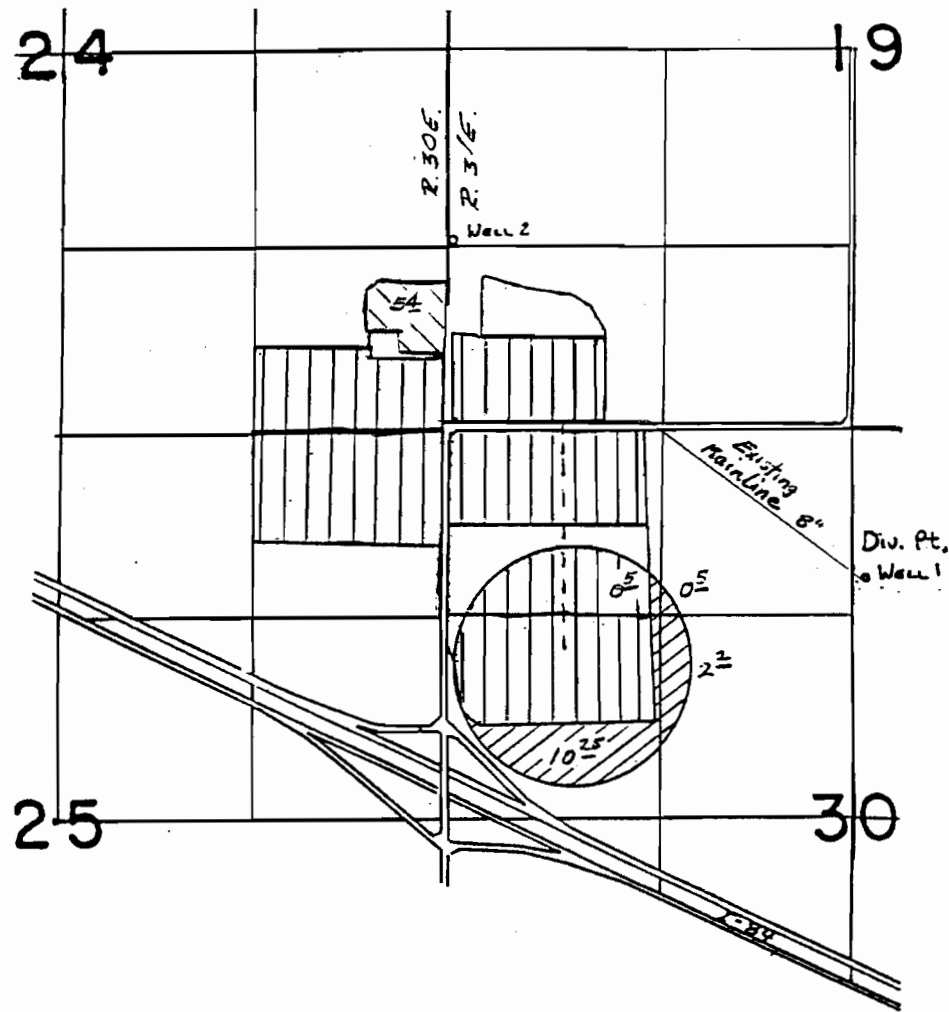

Scale
1" = 1320'



Existing right not subject to transfer - G-5337



Authorized place of use - 13.45 Acs.
subject to transfer



Supplemental - G-5337



Existing right not subject to transfer - G-5337



Proposed place of use - 13.45 Acs.
subject to transfer



Supplemental - G-5337