RECEIVED
NOV 24 1987
WATER RESOURCES DEPT
SALEM, OREGON

TOWNSHIP 16 SOUTH, RANGE 3 WEST, W.M.

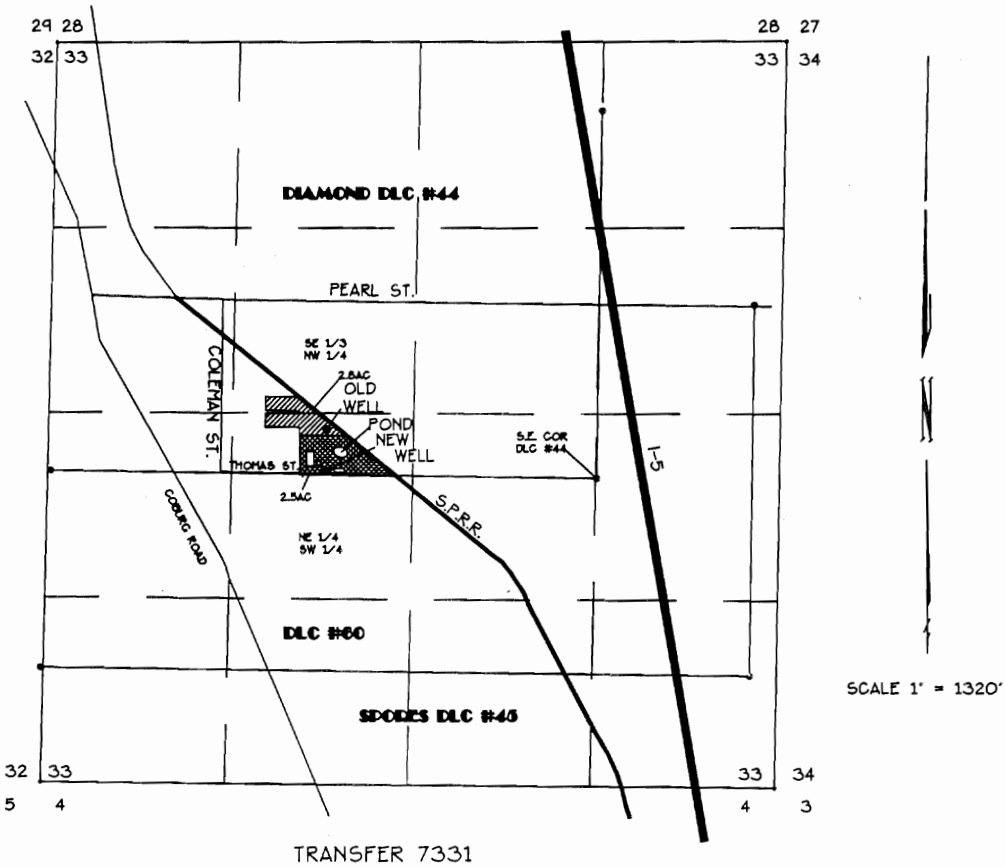

TRANSFER 7331

WELL LOCATIONS:

OLD WELL - 320 FEET NORTH
1998 FEET WEST OF
THE S.E. COR DLC #44

NEW WELL - 36.44 FEET NORTH +
2015.94 FEET WEST OF
THE S.E. COR DLC #44

LOCATION OF BENEFICIAL USE OF WATER FROM NEW WELL LOCATION

LOCATION OF PERMIT #G-666
CERT. VOL 22 PG 30282

Certified Water Right Examiner
#047 WRE
H. Timothy Fassbender
H. TIMOTHY FASSBENDER
NOV. 19, 1987
STATE OF OREGON

FINAL PROOF SURVEY
FOR
ERIC G. & SHERI L. OLSON
32815 E. THOMAS STREET
PO BOX 8517
CORBURG, OR 97408
PH (541) 683-8471
BY
FORD-NESS-FASSBENDER
PO BOX 22735
EUGENE, OR 97402
PH (541) 344-1852
NOVEMBER 19, 1987

JOB NO. 1772.01
DWG NO. C1772-01F.DWG