


T. 9S. R. 4W. WM.

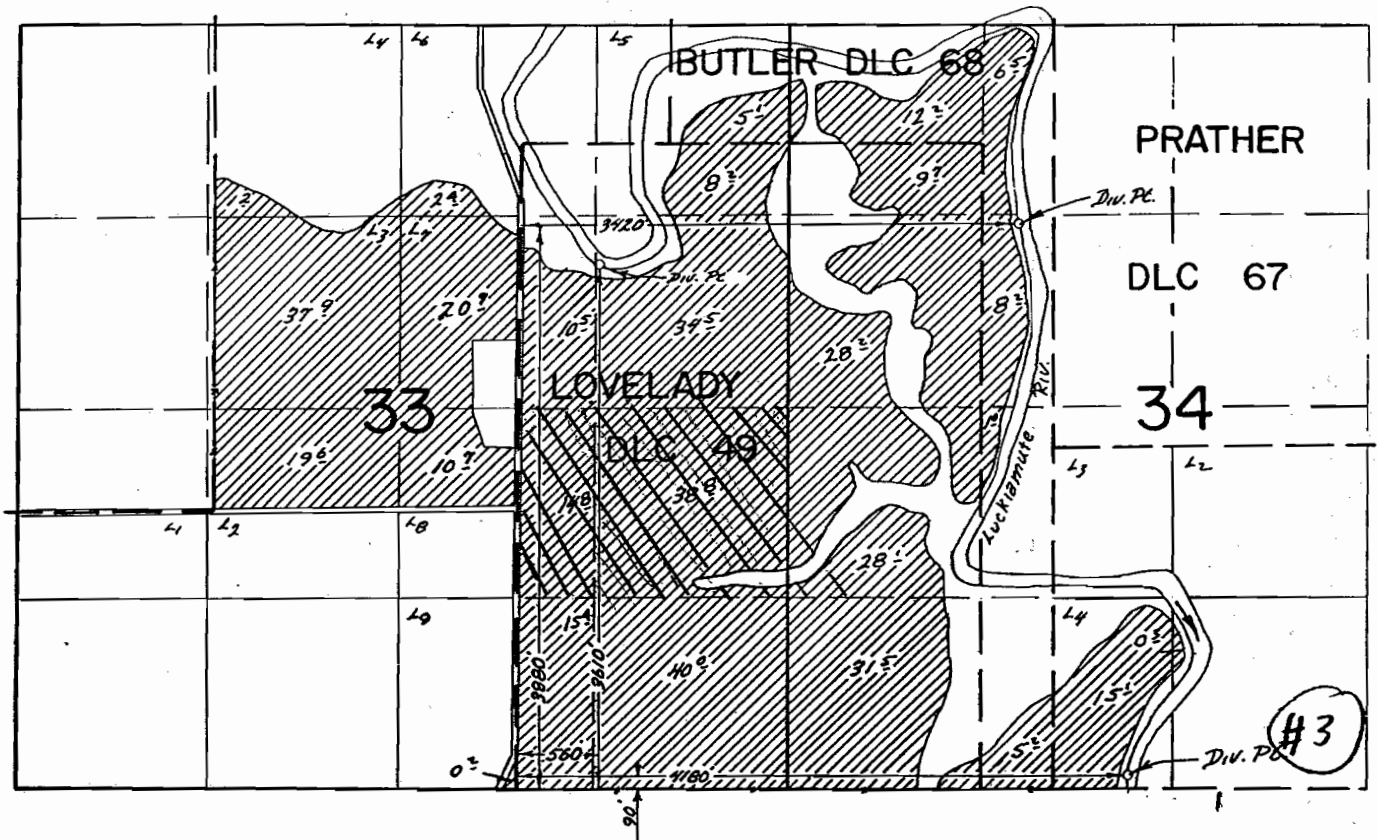

 = From
= To

FINAL PROOF SURVEY
UNDER

Application No. 42040 Permit No. 31469
IN NAME OF

DONALD HECTOR

Surveyed March 26 1978, by R. G. Nucken

RECEIVED

MAR 25 2002

WATER RESOURCES DEPT.
SALEM, OREGON

T-9068