



Township 1 South, Range 2 West, W. M.
Section 26

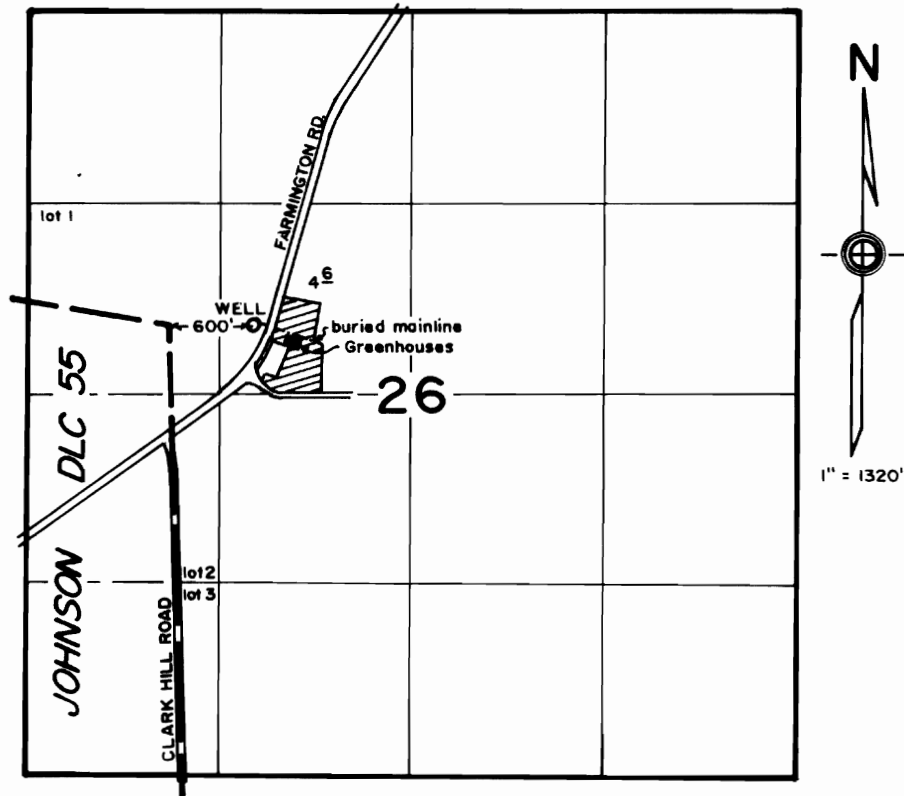

FINAL PROOF SURVEY
under
Transfer 6485
in name of
HARDROCK ENTERPRISES
March 9, 1993

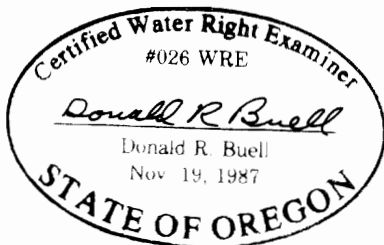

THIS MAP WAS PREPARED FOR THE PURPOSE OF IDENTIFYING THE LOCATION OF A WATER RIGHT ONLY AND IS NOT INTENDED TO PROVIDE LEGAL DIMENSIONS OR LOCATION OF PROPERTY OWNERSHIP LINES.