

RECEIVED

T. 16 S., R. 4 W., U.S.W.M.

SECTION 12 & 13

FINAL PROOF SURVEY

UNDER


TRANSFER FILE T- 7364

IN NAME OF
HUGH MALPASS

MUDGY CREEKS IRRIGATION PROJECT

PRIORITY : 1.) FEBRUARY 9, 1939


DATE : 2.) OCTOBER 2, 1986

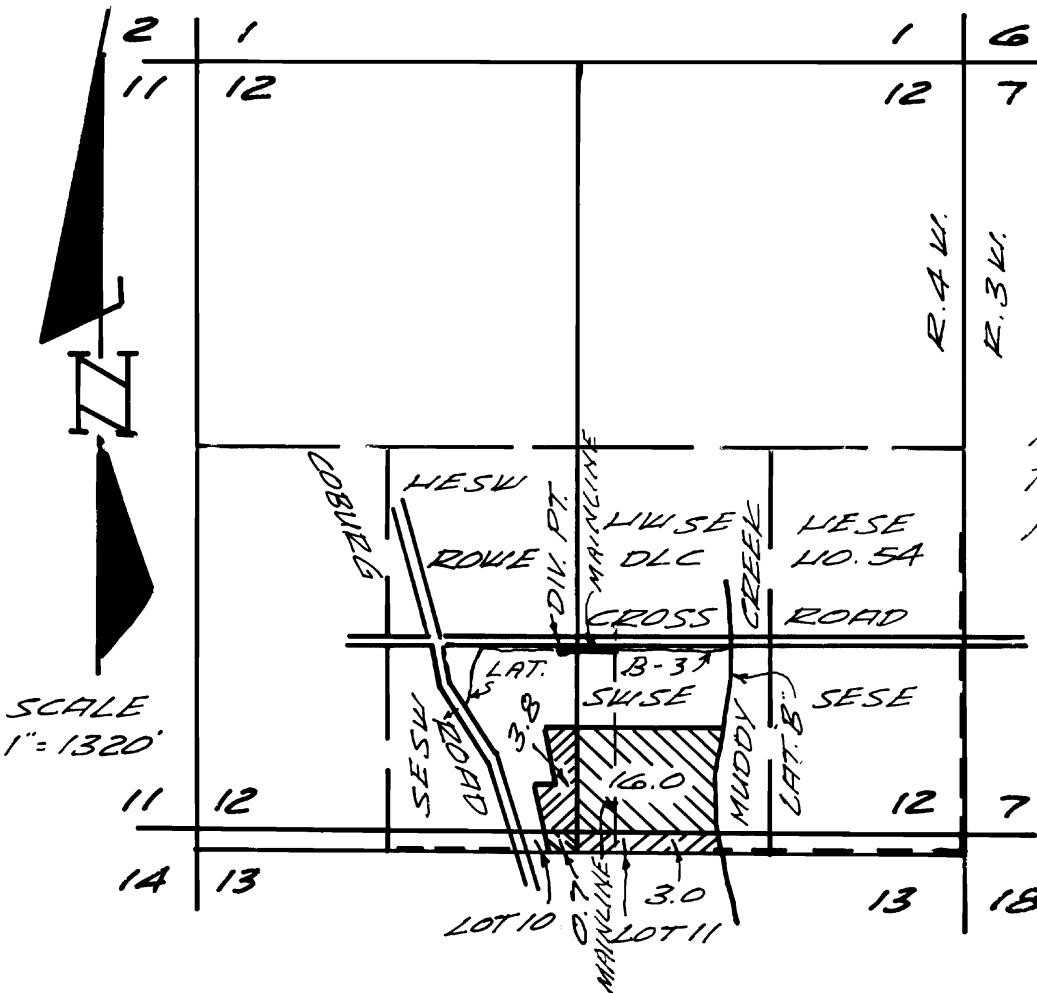

MUDGY CREEK
LOCAL POINT OF
DIVERSION IS 1405'
FEET NORTH AND
2730' WEST OF SE
COR. ROWE DLC 54

SOURCE: MCKENZIE
RIVER, A TRIBUTARY
TO THE WILLAMETTE
RIVER.

THIS MAP IS FOR WATER PURPOSES
ONLY AND IS NOT INTENDED TO
PROVIDE DIMENSIONS FOR LOCATING
PROPERTY BOUNDARIES.

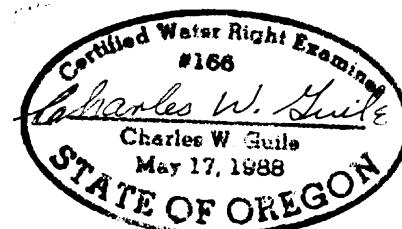

94-57