


T. 1S. R. 2W. W.M.

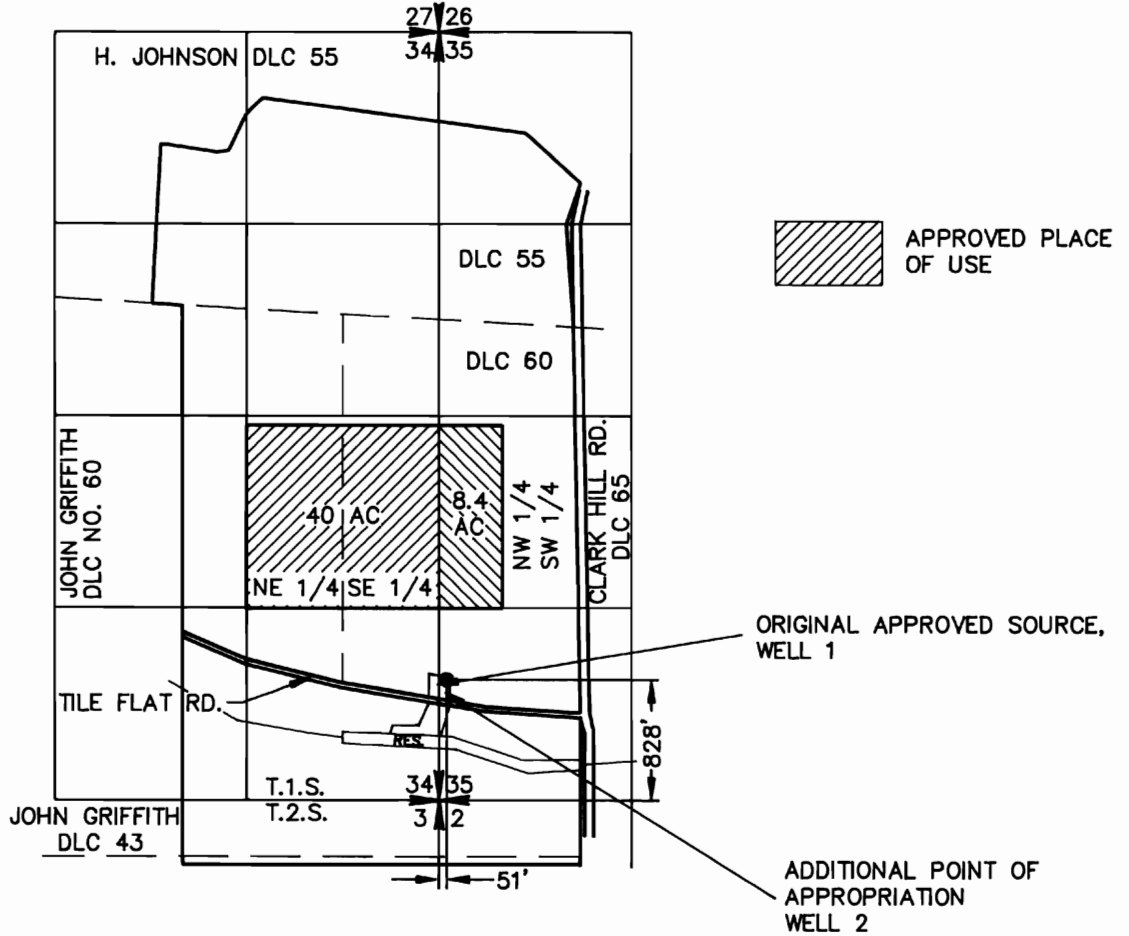

# FINAL PROOF SURVEY


UNDER

## TRANSFER APPLICATION T-7365


IN THE NAME OF

### ROSS ISLAND SAND & GRAVEL CO.

SURVEYED JULY 9, 1999 , BY JOHN R. THOMAS

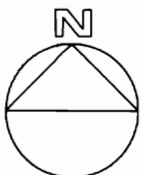

SCALE: 1" = 1320'

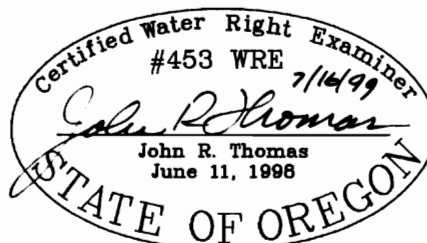

THIS MAP IS FOR THE PURPOSES OF IDENTIFYING THE LOCATION OF THE WATER RIGHT ONLY AND IS NOT INTENDED TO PROVIDE LEGAL DIMENSIONS OR THE LOCATION OF PROPERTY OWNERSHIP LINES.

EXPIRES 06/30/00