


T.10S. R.2W.W.M.

MAY 2000

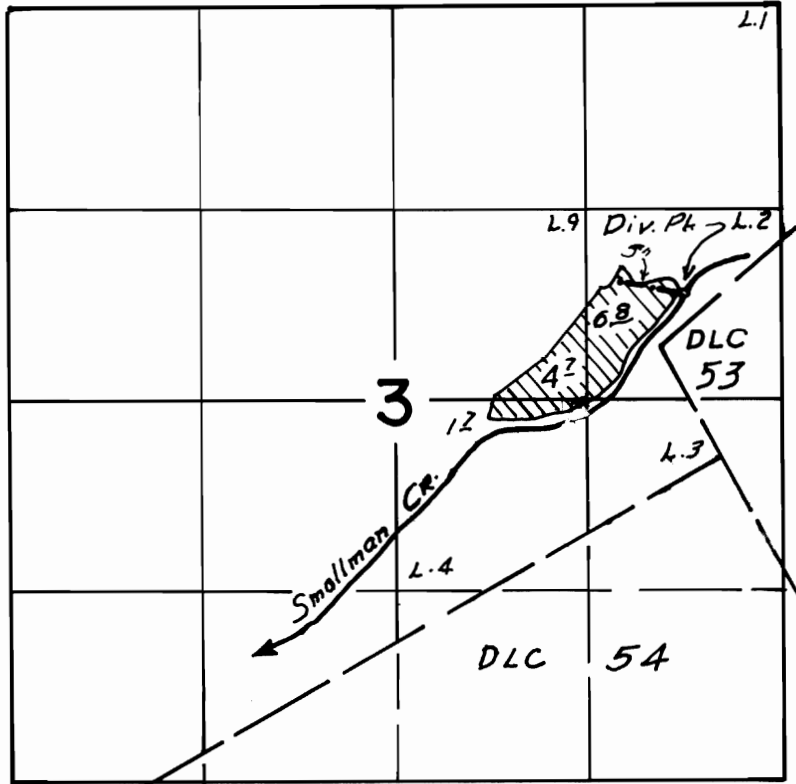

Scale  
4" = 1 Mi.


Div. Pt. loc. 430' N & 180' E from W 1/4 NW Cor DLC 53

### FINAL PROOF SURVEY UNDER

Transfer No. T-7375  
Application No. .... Permit No. ....  
IN NAME OF

MT. JEFFERSON FARMS

Surveyed April 24, 2000, by .....

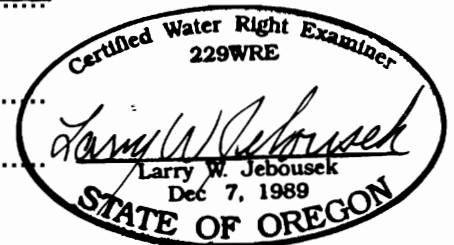

THIS MAP WAS PREPARED FOR THE PURPOSE OF IDENTIFYING THE LOCATION OF A WATER RIGHT ONLY AND IS NOT INTENDED TO PROVIDE LEGAL DIMENSIONS OR LOCATION OF PROPERTY OWNERSHIP LINES.