

NW 1/4 SW 1/4, SW 1/4 SW 1/4, SEC. 8


NW 1/4, NW 1/4 SW 1/4, SE 1/4 SW 1/4, SEC. 17

ALL SEC. 18

NW 1/4, N 1/2 NE 1/4, SW 1/4 NE 1/4, N 1/2 SW 1/4, NW 1/4 SE 1/4, SEC. 19

POINT OF DIVERSION IS IN SE 1/4 NE 1/4, SEC. 16

8

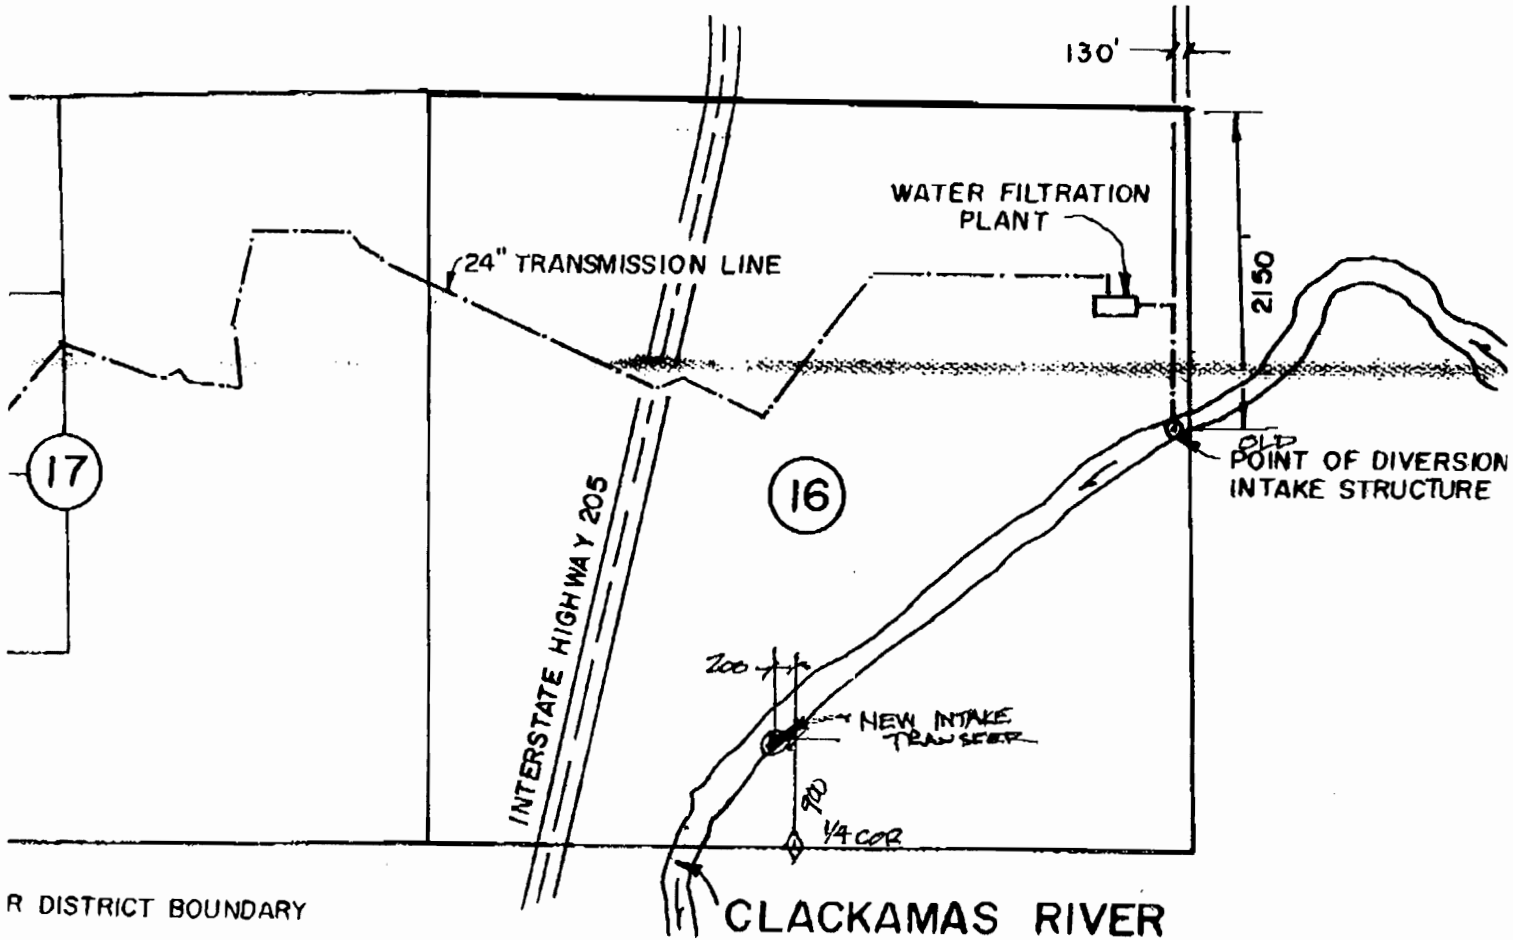

~~FINAL PROOF SURVEY~~

UNDER

CERTIFICATE NO. _____

APPLICATION NO. 47144 PERMIT NO. 35297

IN NAME OF OAK LODGE WATER DISTRICT
SURVEYED ~~DEC. 19, 1994~~

BY

G. ROBERT TAYLOR CWRE

SE 1/4, SW 1/4, SEC. 16,