


T.2N. R.28E. W.M.

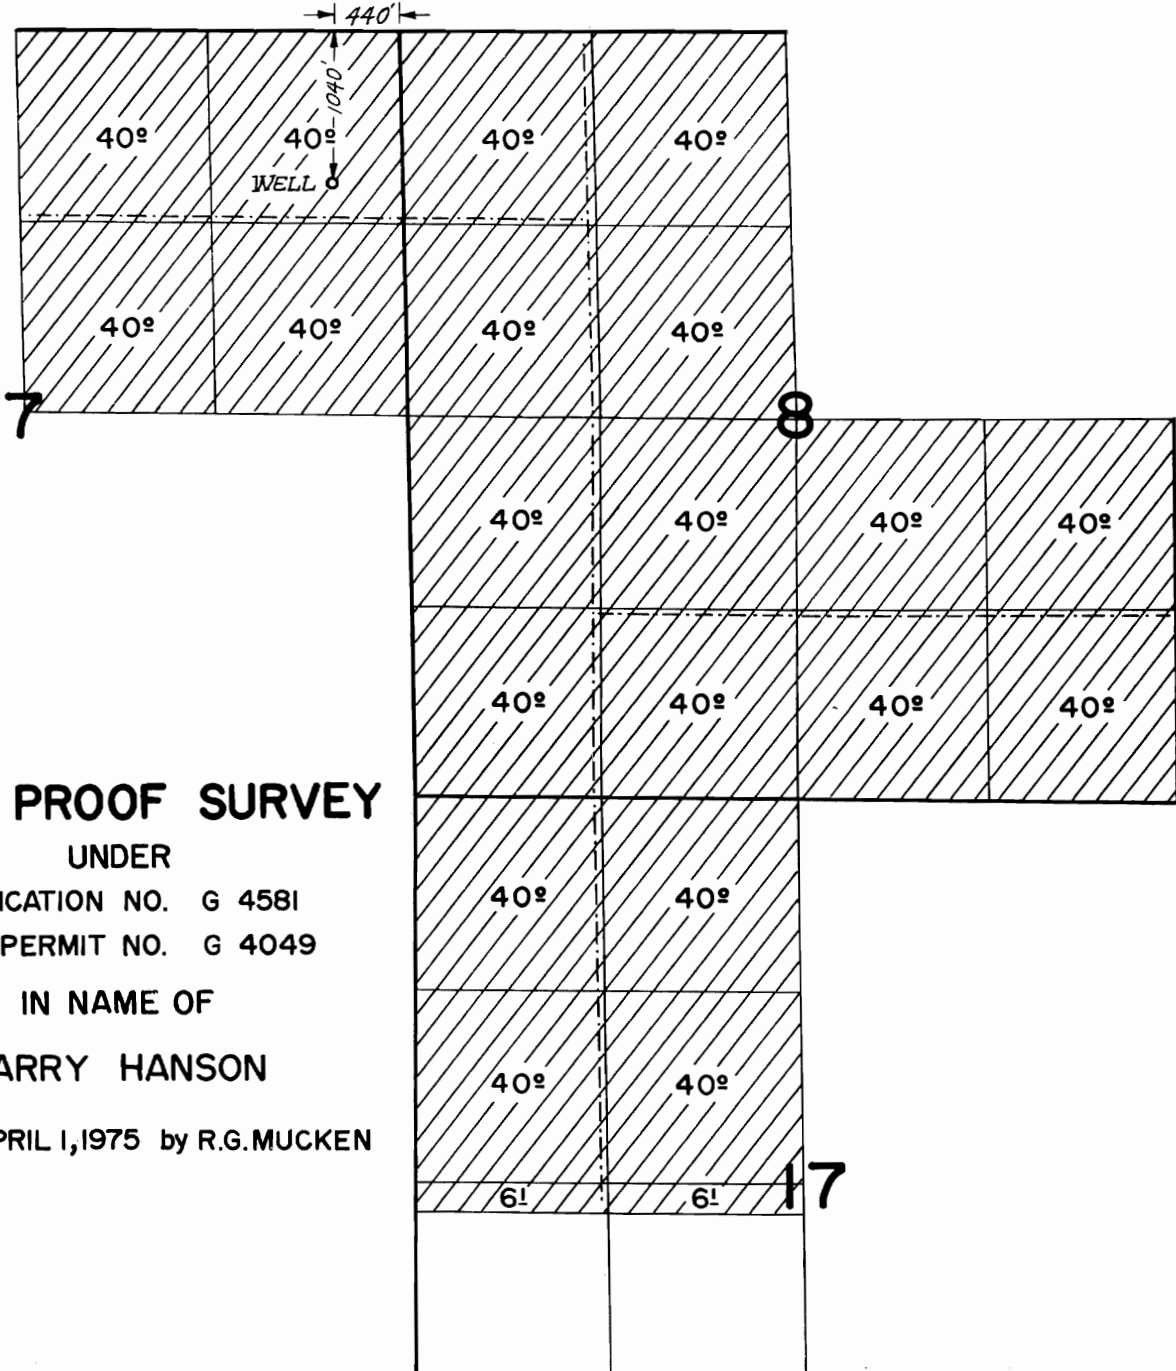

FINAL PROOF SURVEY

UNDER

APPLICATION NO. G 4581

PERMIT NO. G 4049

IN NAME OF

LARRY HANSON

SURVEY: APRIL 1, 1975 by R.G. MUCKEN