

A PORTION OF THE SE 1/4, SECTION 23,
TOGETHER WITH PORTIONS OF SECTION 26
TOWNSHIP 1 SOUTH, RANGE 1 WEST, W.M.

**CLAIM OF
BENEFICIAL USE MAP
REDTAIL GOLF COURSE**

TRANSFER T-1321
(ALSO, SEE APPLICATION S-80118,
PERMIT 51944, AND APPLICATION R-80117,
PERMIT R-11635)
IN THE NAME OF
THE CITY OF PORTLAND,
PARKS AND RECREATION
SITUATED IN TAX LOTS 1S1W23DC-04200,
1S1260000100, 1S1260000200, T1S, R1W, W.M.,
WASHINGTON COUNTY, OREGON
SURVEY COMPLETED FEBRUARY 4, 2004
BY DAN A. BUTTS, CURE
FOR CITY OF PORTLAND
PARKS AND RECREATION

RECEIVED

MAR 31 2005

WATER RESOURCES DEPT
SALEM, OREGON

COBU MAP # 0161



SCALE: 1"=400'

NE 1/4, NW 1/4, SEC. 26
TRANSFER FROM: 4.37 ACRES
TRANSFER TO: 4.98 ACRES
DRIED UP: 0.00 ACRES
UNCHANGED: 21.03 ACRES

SW 1/4, SE 1/4, SEC. 23
TRANSFER FROM: 1.41 ACRES
TRANSFER TO: 1.39 ACRES
DRIED UP: 0.18 ACRES
UNCHANGED: 7.21 ACRES

NW 1/4, NE 1/4, SEC. 26
TRANSFER FROM: 3.68 ACRES
TRANSFER TO: 3.18 ACRES
DRIED UP: 5.73 ACRES
UNCHANGED: 22.99 ACRES

SE 1/4, NW 1/4, SEC. 26
TRANSFER FROM: 2.73 ACRES
TRANSFER TO: 2.43 ACRES
DRIED UP: 3.41 ACRES
UNCHANGED: 21.40 ACRES

WELL #16 LOCATED 140 FEET
SOUTH AND 260 FEET EAST
FROM THE N 1/4 OF SECTION 26

SW 1/4, NE 1/4, SEC. 26
TRANSFER FROM: 1.35 ACRES
TRANSFER TO: 0.96 ACRES
DRIED UP: 4.57 ACRES
UNCHANGED: 20.68 ACRES

PUMP STATION IS LOCATED 2041
FEET SOUTH AND 282 FEET WEST
FROM THE N 1/4 OF SECTION 26

WELL #2 IS LOCATED 2062 FEET
SOUTH AND 252 FEET WEST FROM
THE N 1/4 OF SECTION 26

NE 1/4, SW 1/4, SEC. 26
TRANSFER FROM: 0.00 ACRES
TRANSFER TO: 0.62 ACRES
DRIED UP: 0.00 ACRES
UNCHANGED: 0.00 ACRES

NW 1/4, SE 1/4, SEC. 26
TRANSFER FROM: 0.26 ACRES
TRANSFER TO: 0.24 ACRES
DRIED UP: 0.28 ACRES
UNCHANGED: 0.26 ACRES


LEGEND:

- SECTION LINE
- 1/4, 1/4 SECTION LINE
- PROPERTY LINE
- IRRIGATION MAINLINE
- UNCHANGED PLACE OF USE
(HATCHURE ANGLE CHANGES
BY SECTIONAL SUBDIVISION)
- TRANSFER FROM AREAS
- TRANSFER TO AREAS

NOTES:

NOTE THAT THE MAP SUBMITTED WITH
THE APPLICATION REFERENCED ABOVE
CALLS FOR THE LOCATION OF WELL #1 AS
130 FEET SOUTH & 280 FEET EAST AND
WELL #2 AS 2030 FEET SOUTH & 210 FEET
WEST FROM THE NORTH 1/4 CORNER,
SECTION 26.

LAKE 6 WAS AN EXISTING LAKE AT THE
TIME OF THE ABOVE REFERENCED
APPLICATION AND IS NOT A PART OF THE
SUBSEQUENT PERMIT.

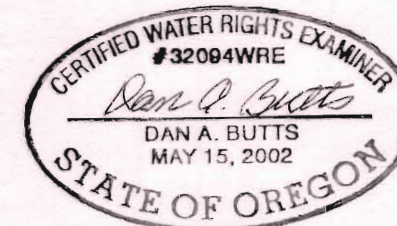

EXPIRATION DATE: 12/31/05

THIS MAP IS TO IDENTIFY A PROPOSED
WATER RIGHT LOCATION. IT IS NOT TO BE
USED TO LOCATE PROPERTY BOUNDARIES.

