


RECEIVED

APR - 3 1995  
WATER RESOURCES DEPT.  
SALEM, OREGON


TOWNSHIP 17 SOUTH, RANGE 21 EAST, W.M.

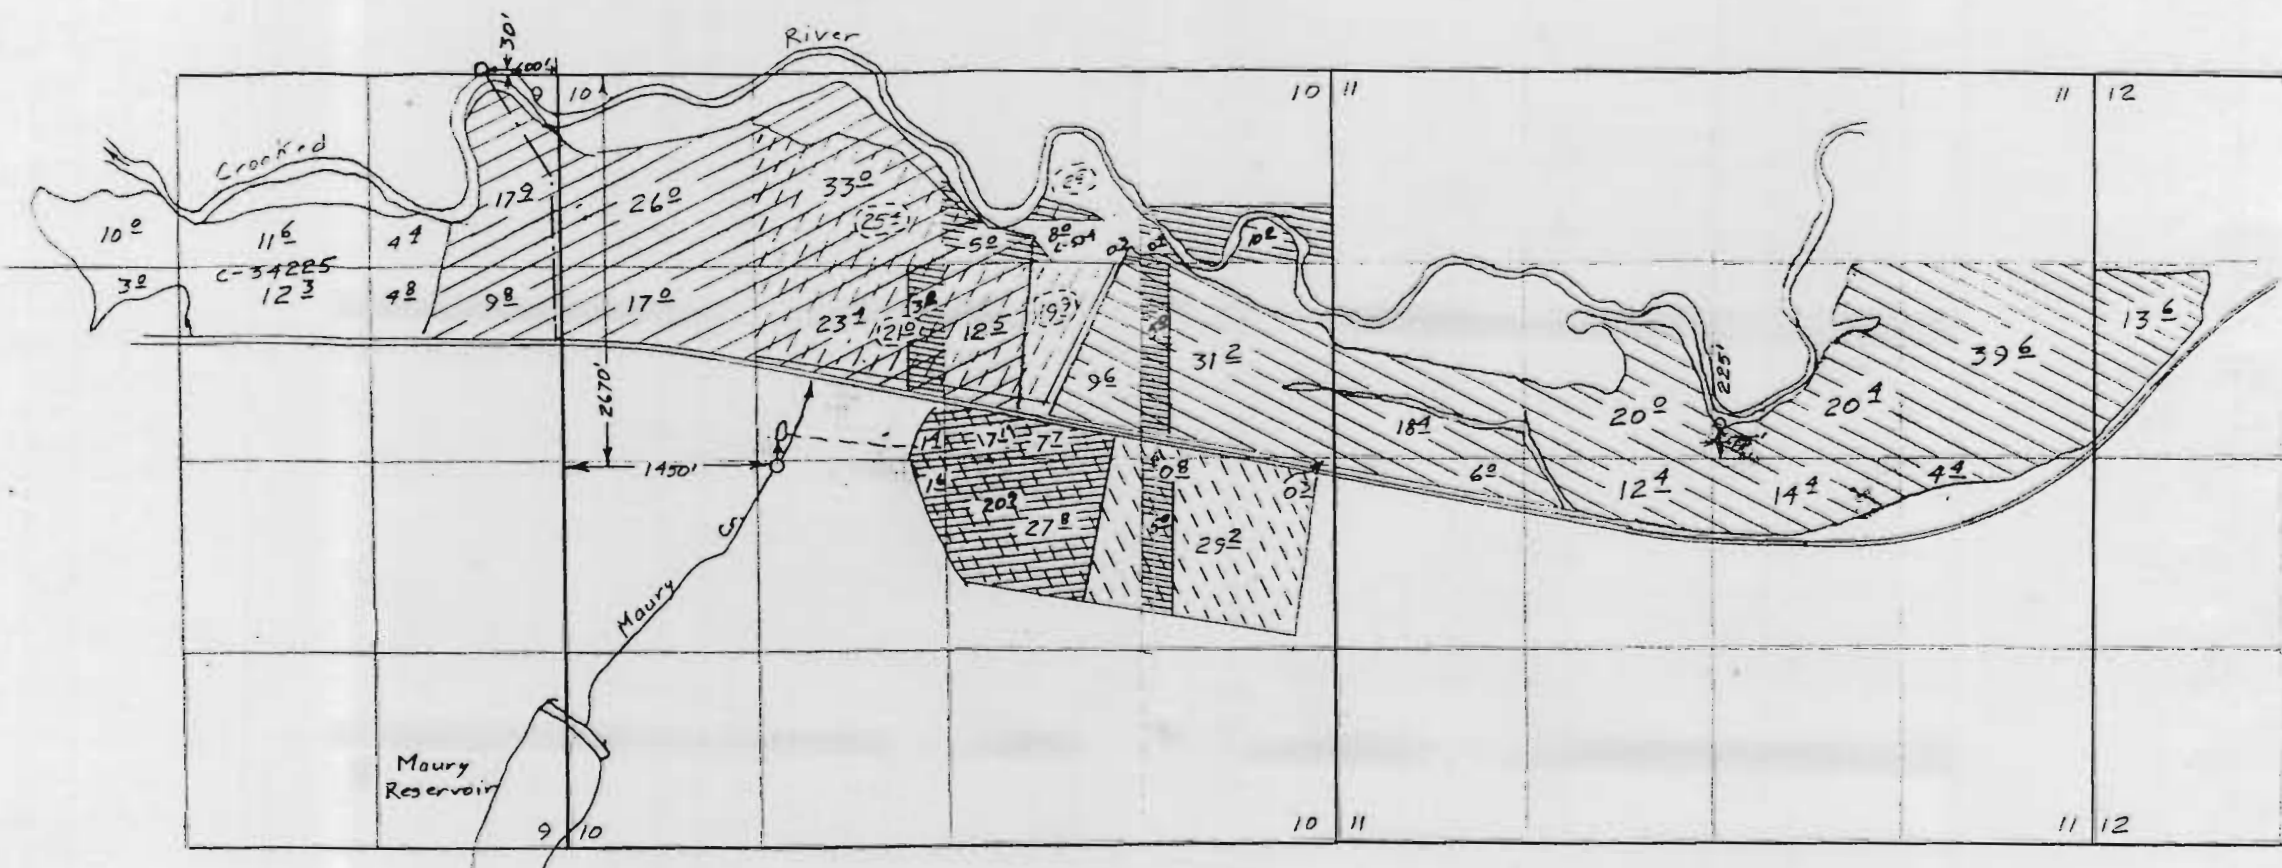

Scale 1" = 1320'

- |         |  |      |       |  |      |         |  |      |
|---------|--|------|-------|--|------|---------|--|------|
| C-32421 |  | FROM | C-534 |  | FROM | C-52349 |  | FROM |
|         |  | TO   |       |  | TO   |         |  | TO   |

Transfer Application Map  
for  
LES SCHWAB TIRE CENTERS, INC.

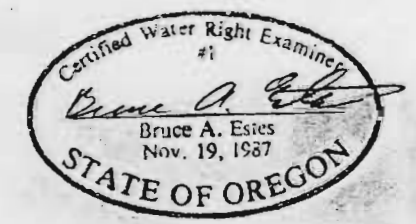

T 7341

This map is for the purpose of locating a water right only and has no intent to provide legal dimensions or the location of property lines.