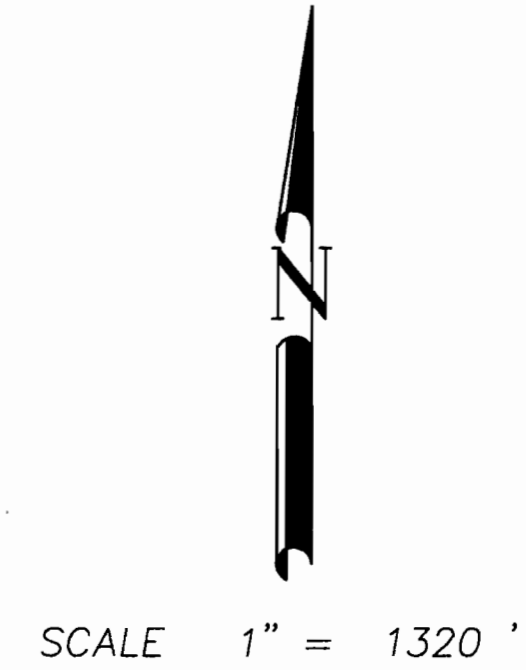
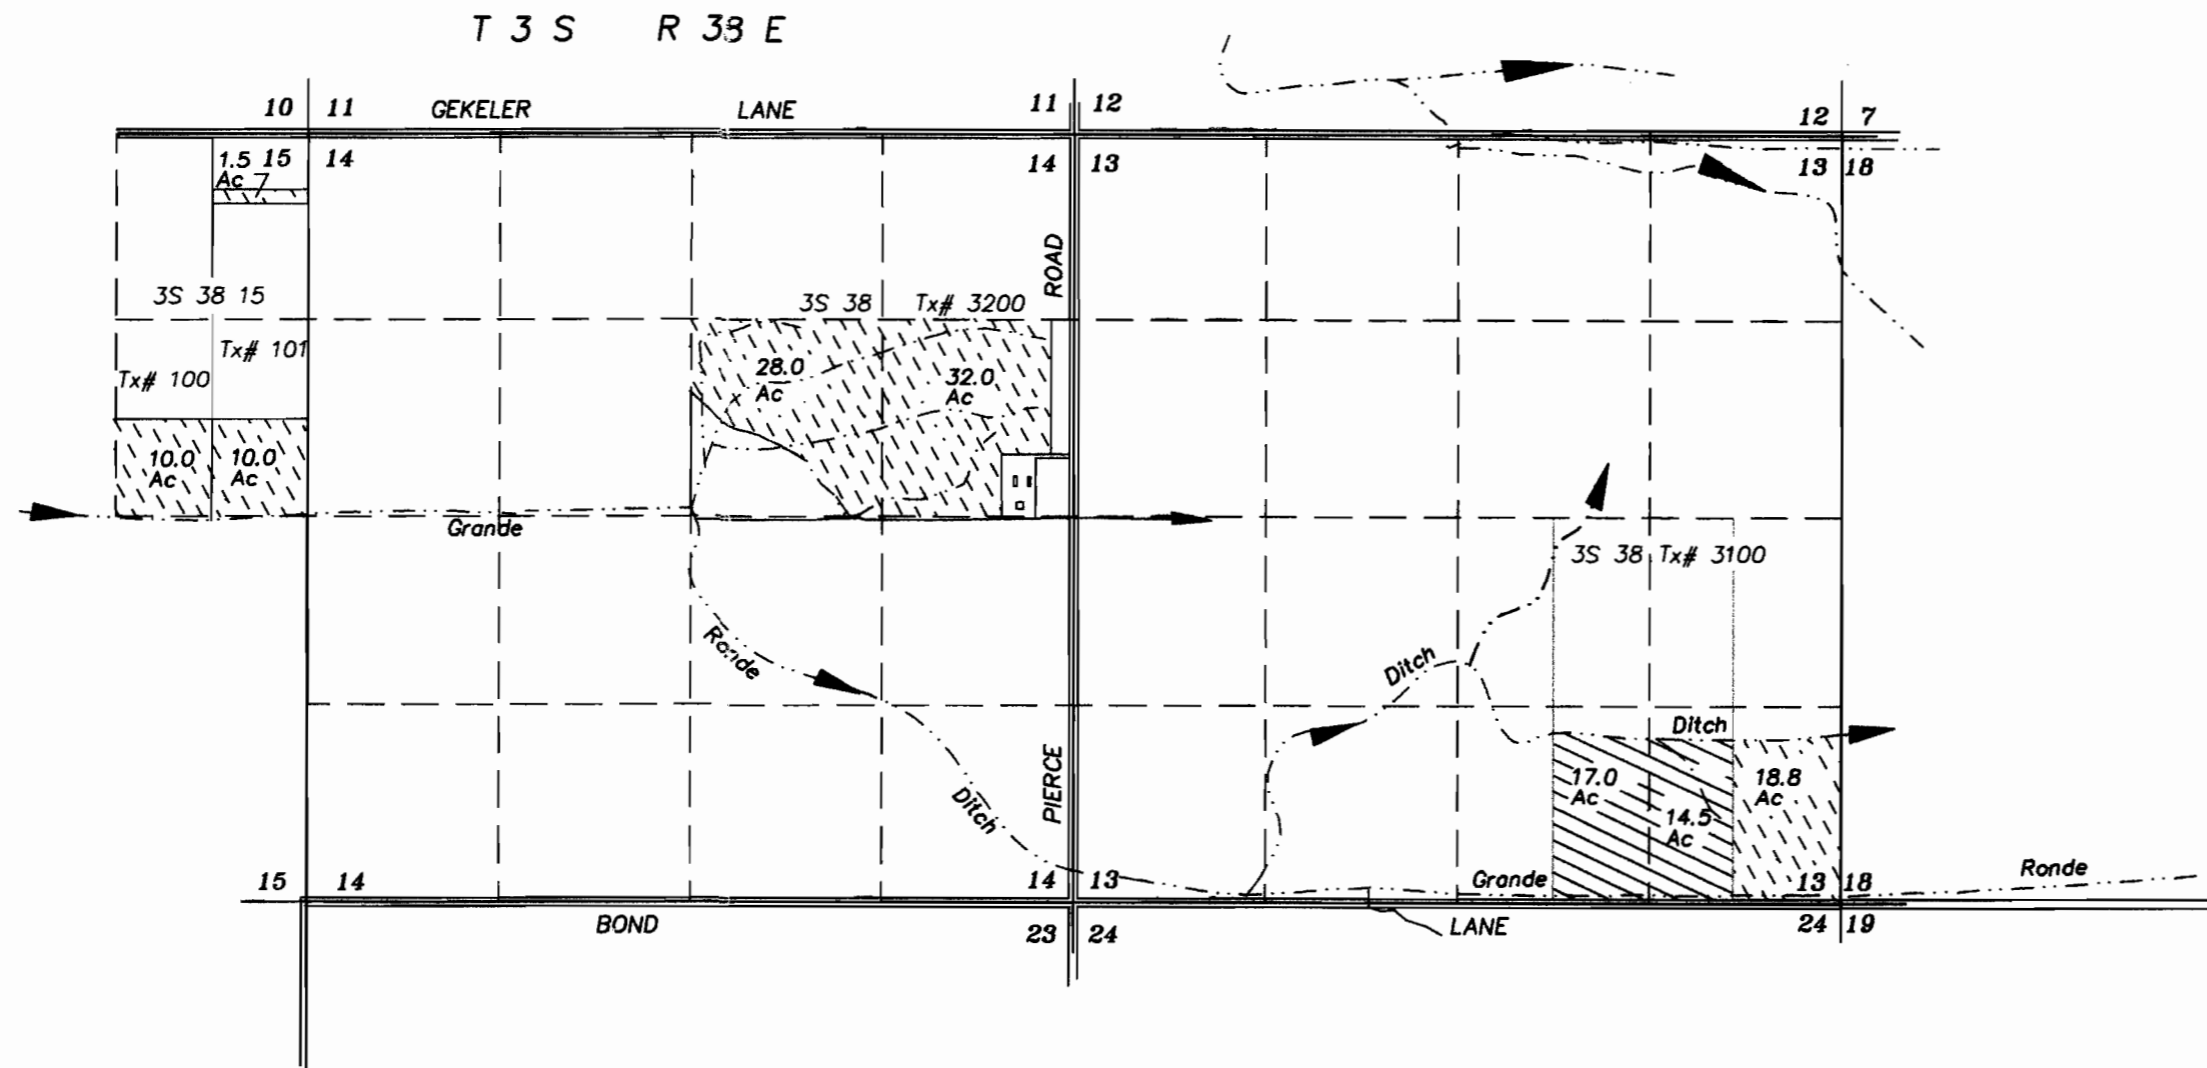

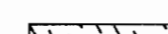
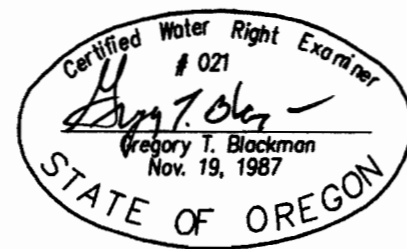
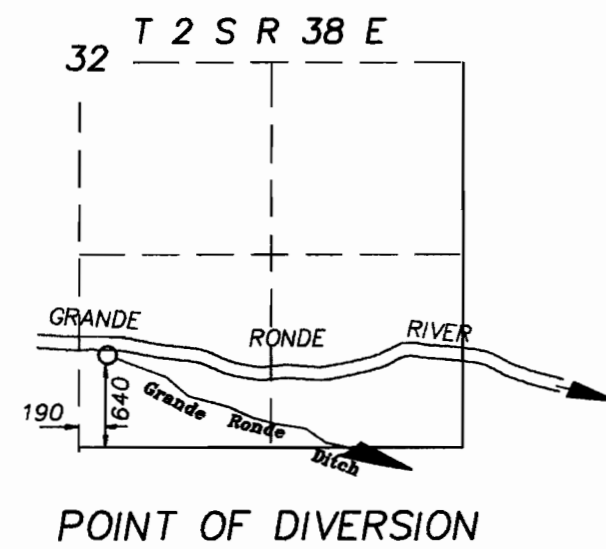


Amended



 Lands irrigated under Transfer Number T- 7361 and having a new point of diversion shown below.

 Lands irrigated under Transfer Number T- 7400



NOTE: The preparation of this map was for the purpose of identifying the location of the proposed water right and has no intent to provide dimensions or location of property ownership lines. Location information shown hereon was furnished by the applicant.

Amended
August 1, 2002

FINAL PROOF MAP FOR
TRANSFERS NUMBERED T-7361 AND T-7400
FOR
GRANDE RONDE VALLEY IMPROVEMENT
DITCH COMPANY
BY
BAGETT - GRIFFITH & BLACKMAN
2006 ADAMS AVENUE
LAGRANDE, OREGON 97850

Application No. T-7361-7400
Permit Number _____

RECEIVED
AUG 19 2002
WATER RESOURCES DEPT.
SALEM, OREGON