


T2S, RIW, WM

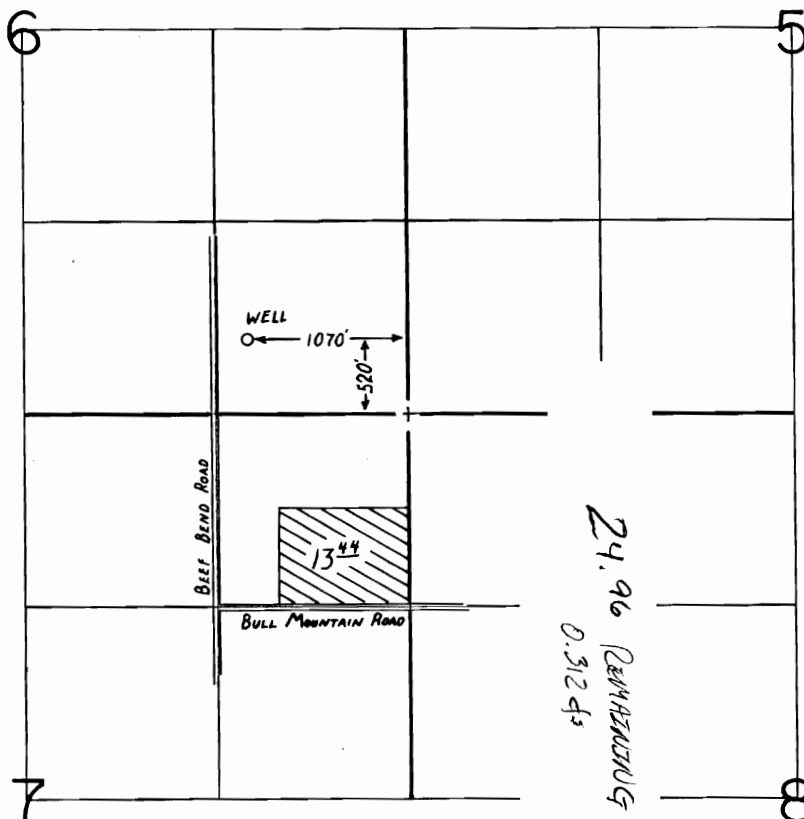

SCALE
1" = 1320'

FINAL PROOF SURVEY UNDER

Transfer 5689
Application No. Permit No.
IN NAME OF

JOSEPH JACKSON, RON TANKERSLEY, JERRY TANKERSLEY

Surveyed JUNE...2... 1988., by J..M...WARREN...