


T. 2 S., R. 2 E., W.M.

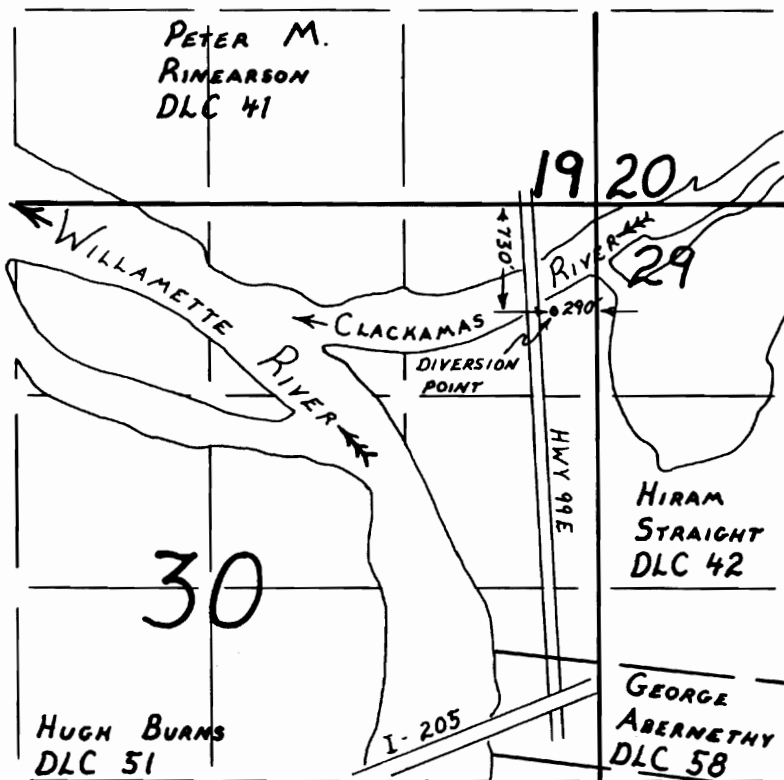

FINAL PROOF SURVEY

UNDER

Application No. 60632 Permit No. 46120  
IN NAME OF

City of Gladstone

Surveyed April 25, 1994, by R.W. Klassen