


T.13 S., R. 32 E., W.M.

RECEIVED

AUG 24 1994

WATER RESOURCES DEPT
SALEM OREGON

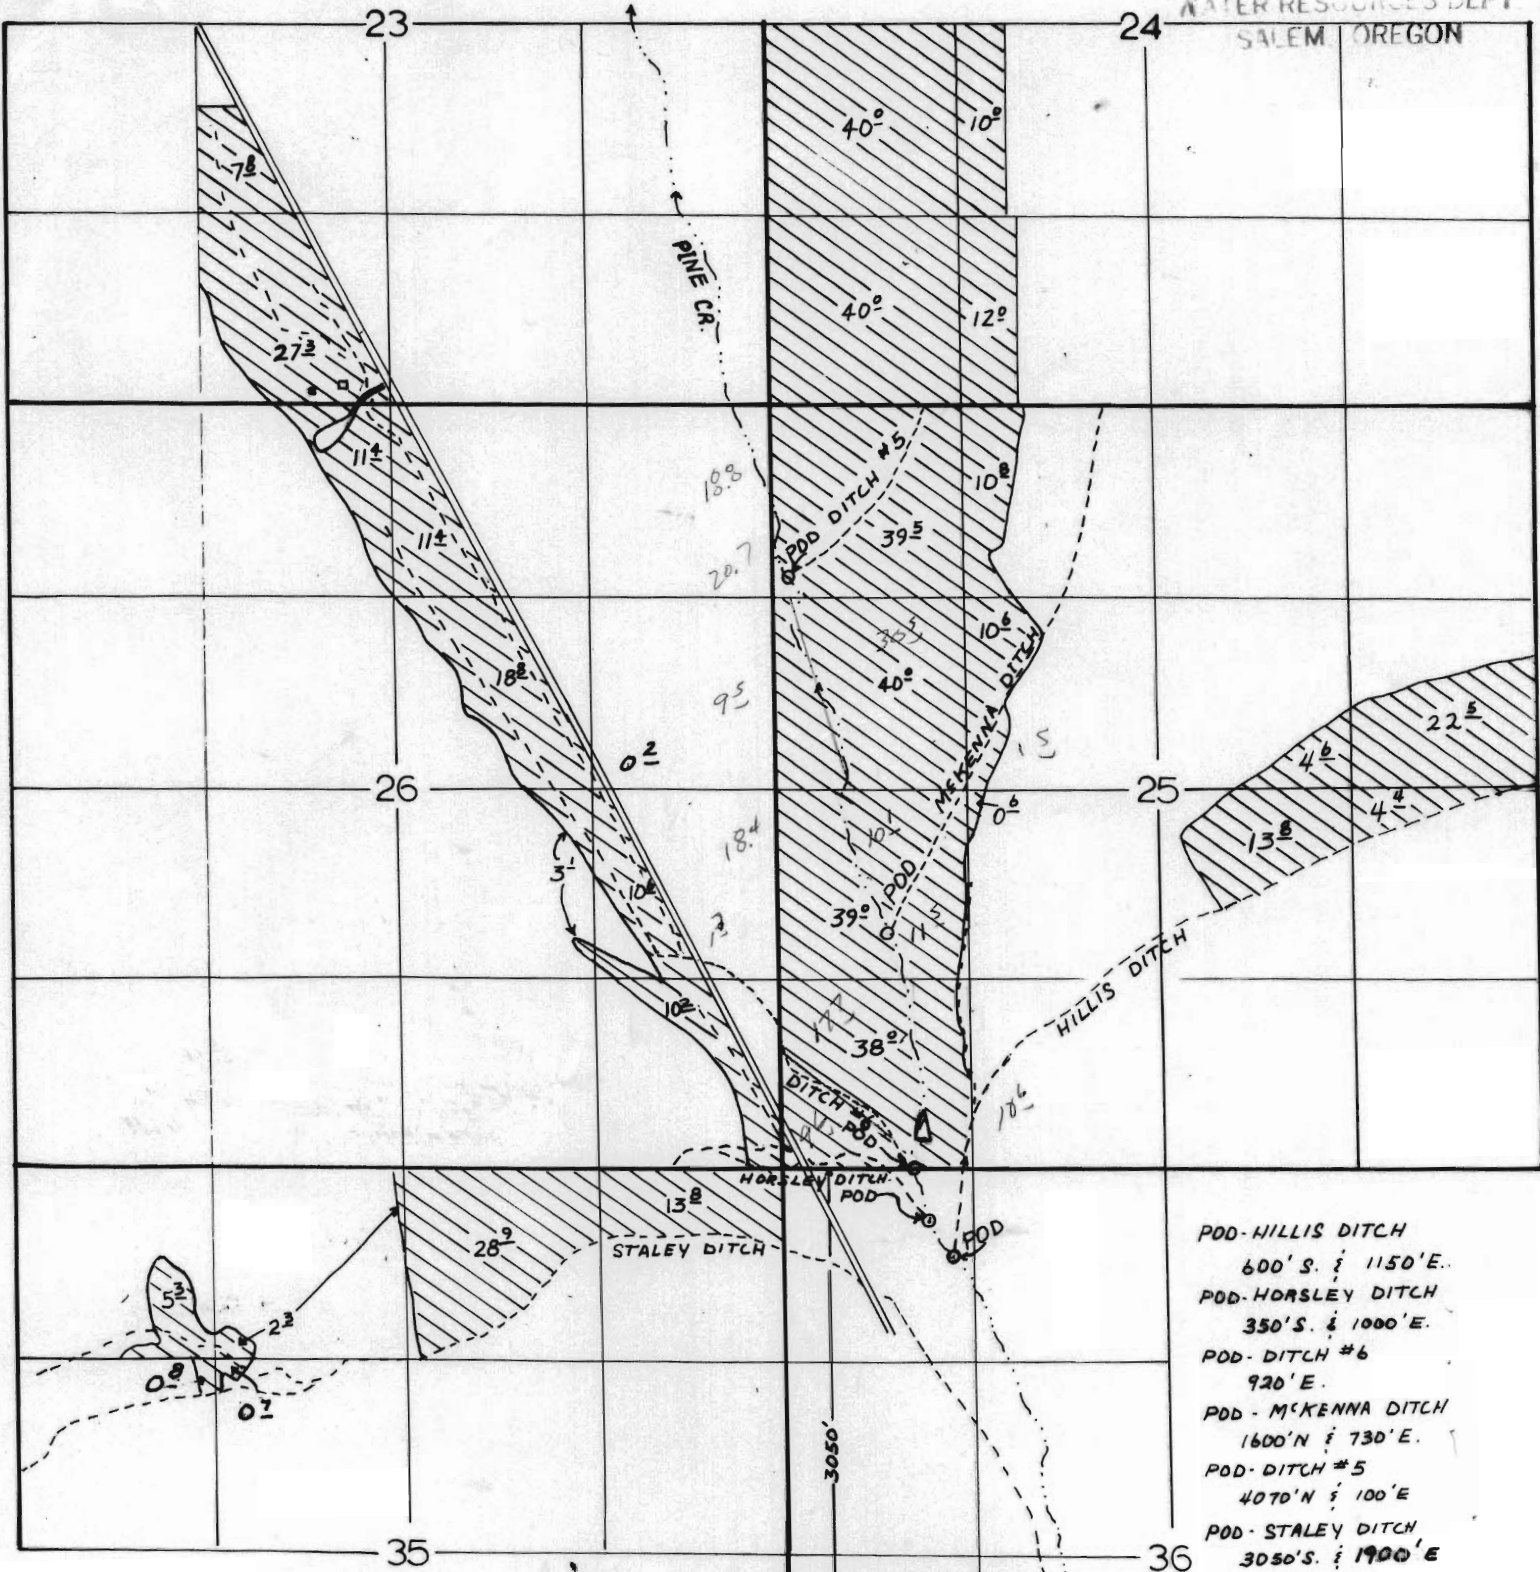

POD - HILLIS DITCH
 600' S. & 1150' E.
 POD - HORSLEY DITCH
 350' S. & 1000' E.
 POD - DITCH #6
 920' E.
 POD - MCKENNA DITCH
 1600' N & 730' E.
 POD - DITCH #5
 4070' N & 100' E
 POD - STALEY DITCH
 3050' S. & 1900' E
 All from N.W. COR. SEC. 36.

FINAL PROOF SURVEY
 UNDER
 Application No. 68698 Permit No. 49885
 IN NAME OF
CLYDE HOLLIDAY AND SONS

Surveyed 4-12-1994, by J. MILLER

Revised 7-28-03 *446*

© 1994 TM 41073-279-571 568

1" = 1320'

