


T.9 S.R.2W. W.M.

RECEIVED

NOV 06 1995

WATER RESOURCES DEPT
SALEM, OREGON

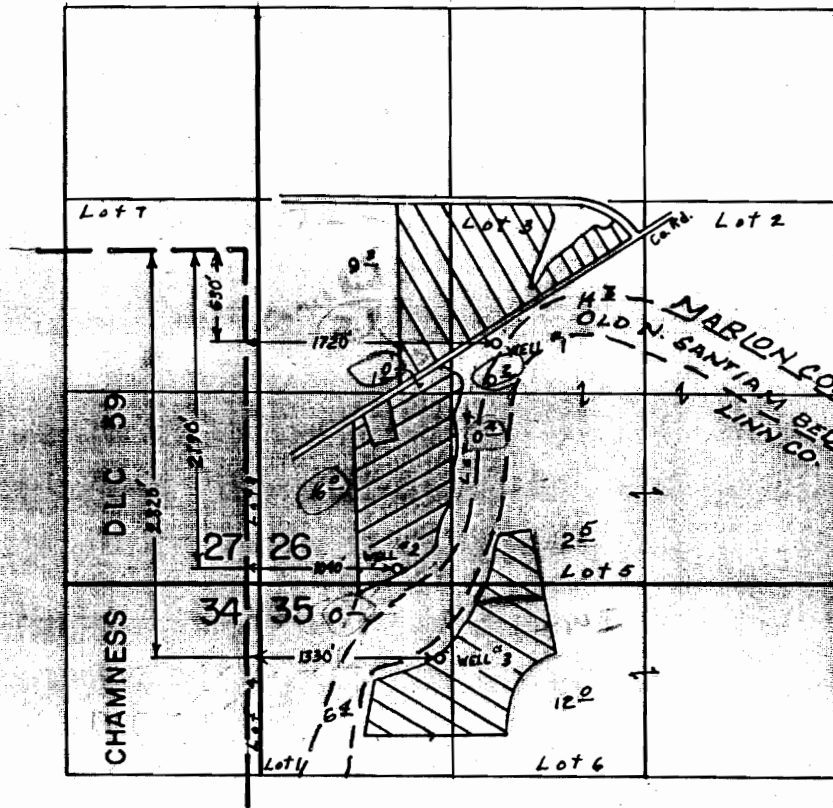

FINAL PROOF SURVEY
UNDER

Application No. G-5066 Permit No. G-4776
IN NAME OF

DENNIS E. & ANNE KOENIG

Surveyed MAY 16 1973, by L.E. GOULD

T-7448