


RECEIVED

NOV 06 1995

WATER RESOURCES DEPT
STATE OF OREGON

T.9S., R.2W., W.M.

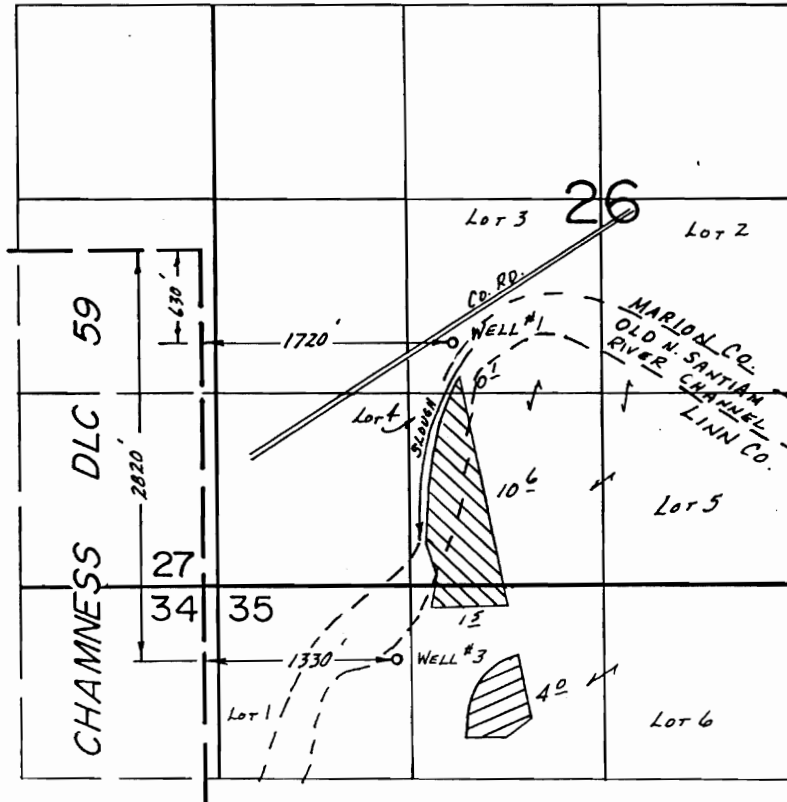

-  Well No. 1
-  Well No. 3

SCALE: 1"=1320'

FINAL PROOF SURVEY UNDER

Transfer No. 3858

IN NAME OF

.....DENNIS E. & ANNE KOENIG.....

Surveyed May 17, 1985, by T.M. WARREN....

T-7449

PTS 1985 L

5/7/86
DUB