

RECEIVED

DEC 30 1997

CLAIM OF BENEFICIAL USE AND FINAL MAP

FOR RICHARD COPISAROW
PARCEL 5, PARTITION PLAT 1993-170
LOCATED IN THE N.W. 1/4 OF SECTION 31
TOWNSHIP 2 SOUTH, RANGE 1 EAST, W.M.
CLACKAMAS COUNTY, OREGON

SCALE 1"=200' SEPTEMBER 15, 1997

APPLICATION NO. T-7457
PERMIT NO. G-6656

25 30
36 31

S.W. DELKER ROAD


NW 1/4 OF
THE NW 1/4

NE 1/4 OF
THE NW 1/4

PARCEL 5
AREA 4.8 ACRES

HOME SITE

WELL SITE
LOCATED 2062' EAST
AND 1155' SOUTH OF
THE N.W. CORNER
OF SECTION 31

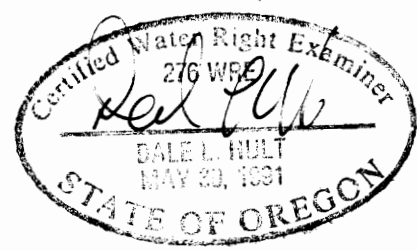

NOTE: THIS DRAWING IS NOT A LAND SURVEY. PROPERTY LINES AND/OR OTHER LINES OF OCCUPATION SHOWN HEREON ARE NOT REPRESENTED BY THE UNDERSIGNED TO MEET ACCURACY STANDARDS OF LAND SURVEYS.



all COUNTY SURVEYORS
& PLANNERS, INC.
P.O. BOX 955
SANDY, OREGON 97055
(503) 668-3151

PROJECT: #97-186