

1996 North Marion
Irrigation District
Temporary Transfer
T.3&4S.R.2WW.M.

RECEIVED


JAN - 2 1996

WATER RESOURCES DEPT.
SALEM, OREGON

RECEIVED

JAN 08 1996

WATER RESOURCES DEPT.
SALEM, OREGON

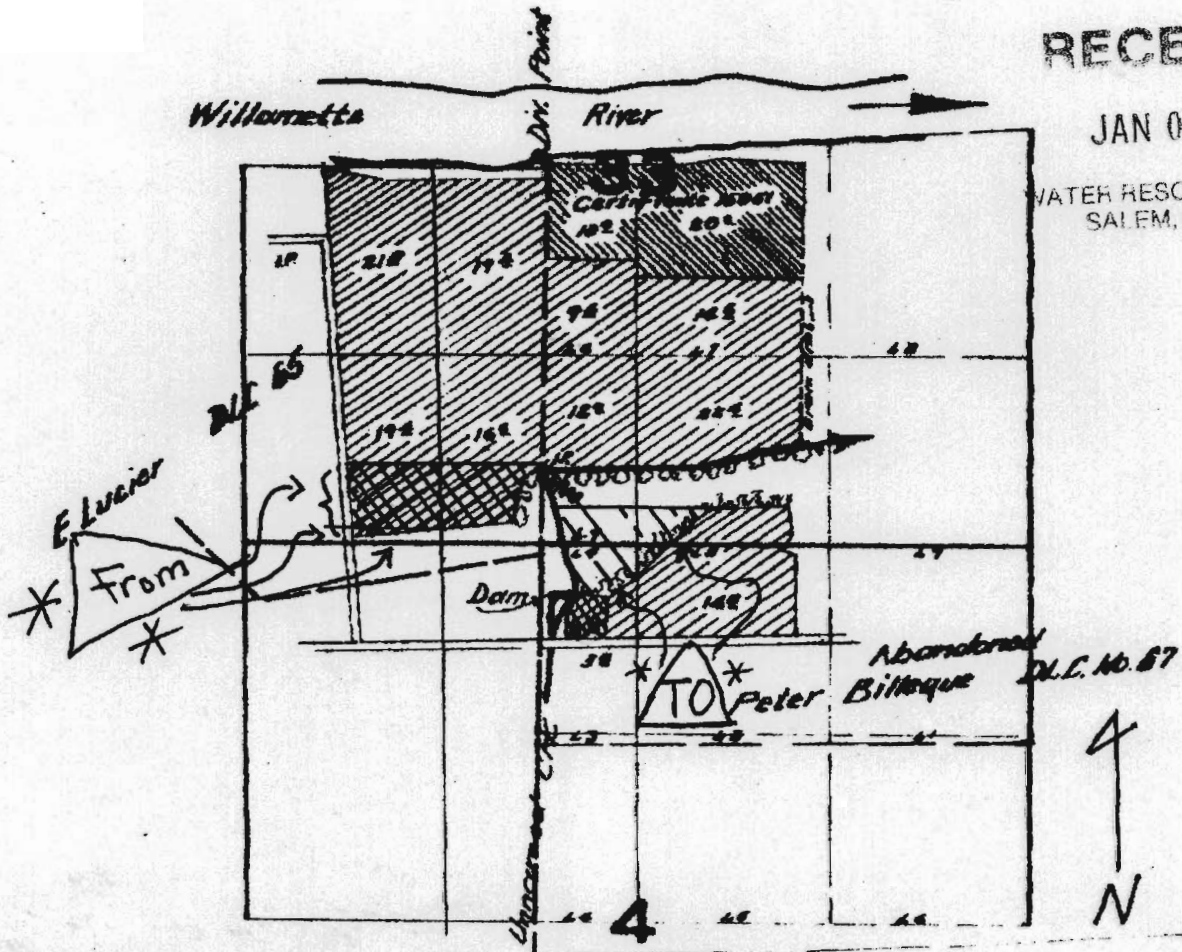

Scale 1" = 1320'
permit 14750 Certificates 19958



From



To

T-7468