
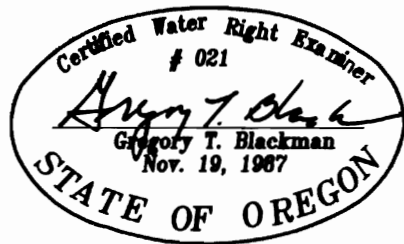


RECEIVED

SEP 2 1999

WATER RESOURCES DEPT
SALEM, OREGON

T 3 S R 36 E

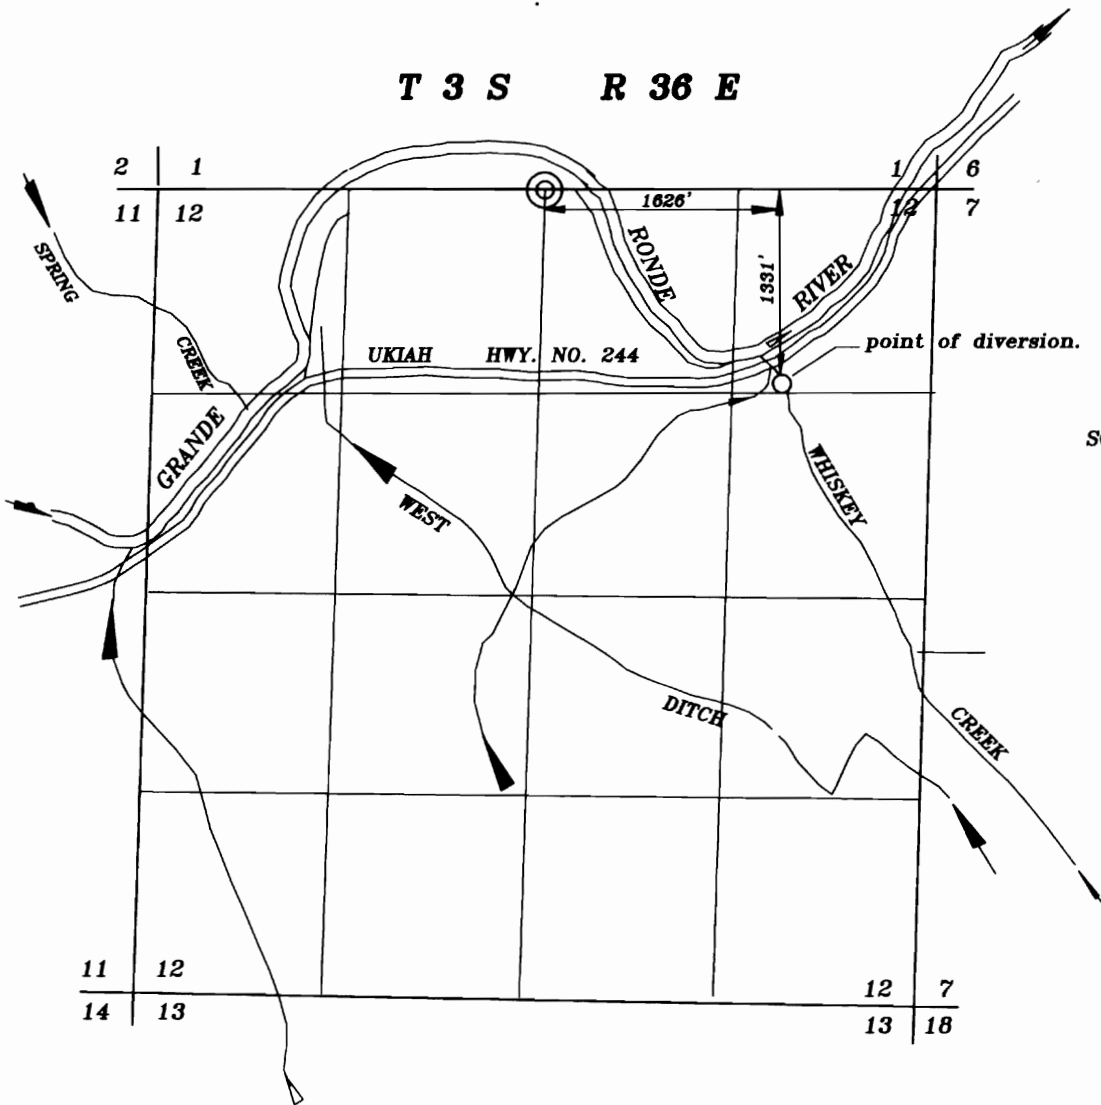

**FINAL PROOF MAP FOR A
CHANGE OF POINT OF
DIVERSION
FOR
DON AND PAT HAMPTON**

BY
BAGETT - GRIFFITH & BLACKMAN
2006 ADAMS AVENUE
LAGRANDE, OREGON 97850

SEPTEMBER 1, 1999

APPLICATION NO. : T- 7470

PERMIT NUMBER _____

NOTE: The preparation of this map was for the purpose of identifying the location of the proposed water right and has no intent to provide dimensions or location of property ownership lines. Location information shown hereon was furnished by the applicant.