


T15 R9WWM

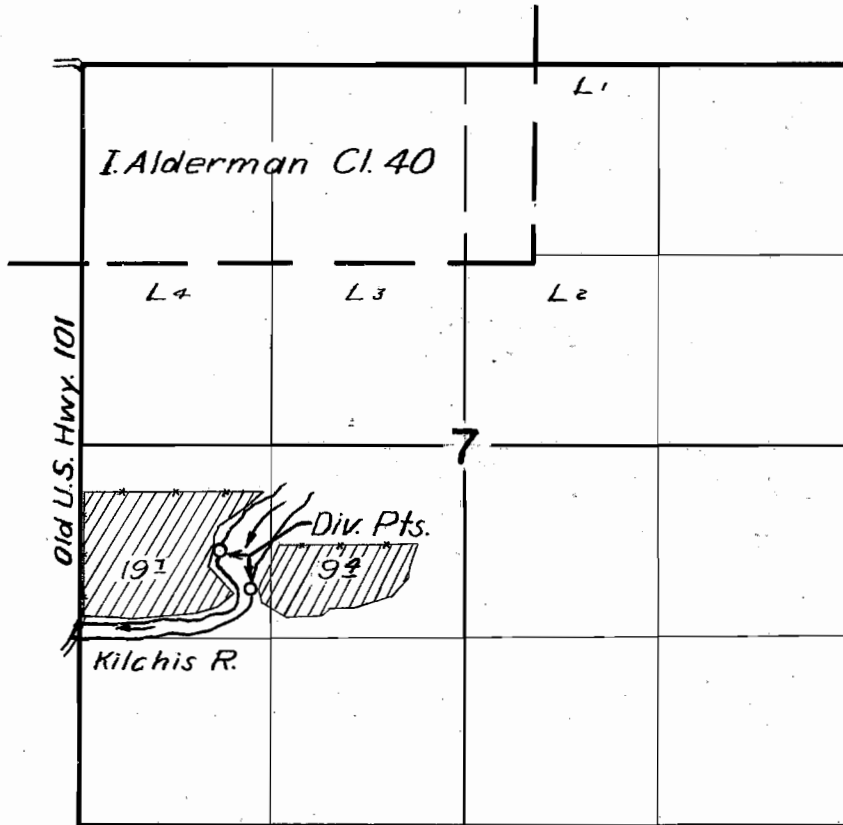

**FINAL PROOF SURVEY**

UNDER

Application No. 28505 Permit No. 22501

IN NAME OF

Martha Pigman

Surveyed July 7, 1955 by M. Bish

1955L