


TOWNSHIP 1 NORTH, RANGE 42 EAST, W.M.

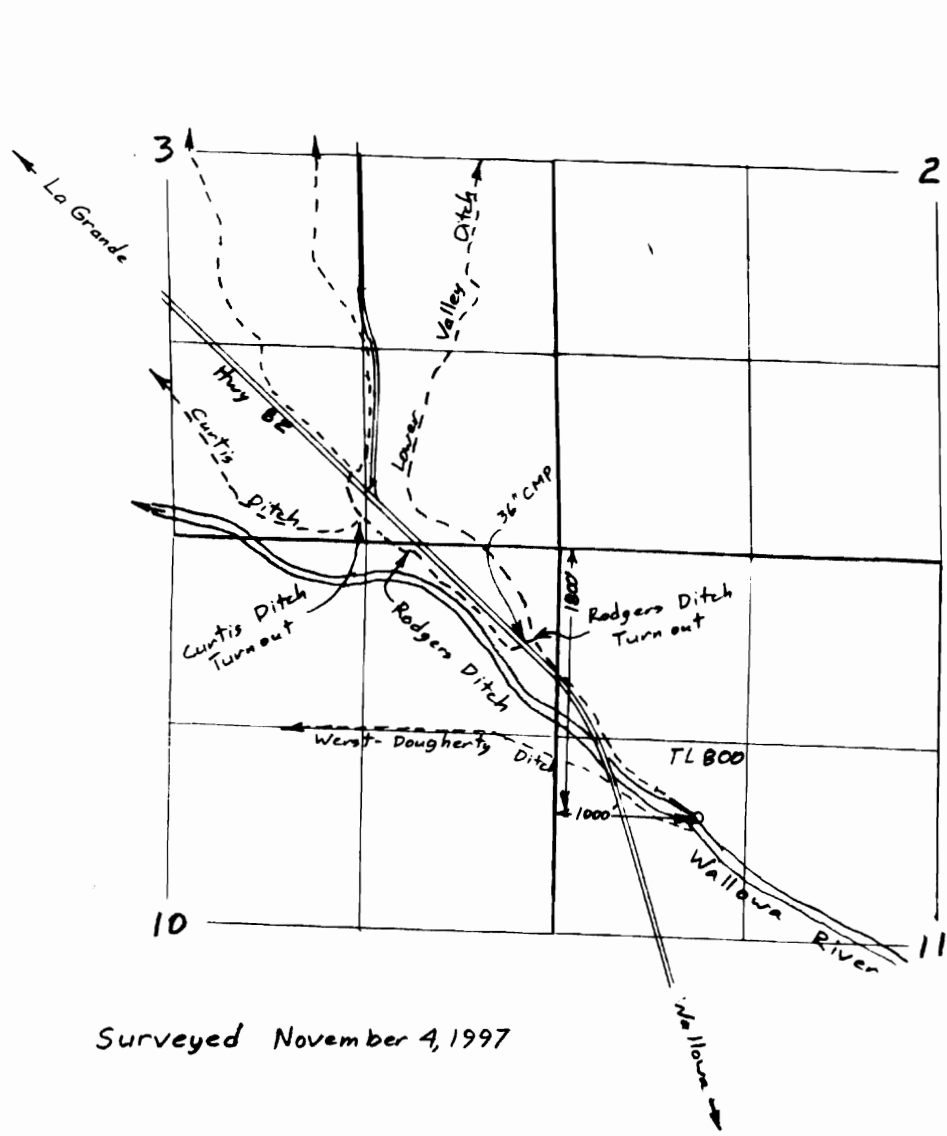

Scale 1" = 1320'

Surveyed November 4, 1997

**RECEIVED**


FEB 09 1998

WATER RESOURCES DEPT  
SALEM OREGON

T-7489

Claim of Beneficial Use Map  
for

LOWER VALLEY WATER IMPROVEMENT DIST.

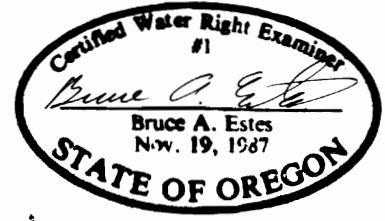

This map is for the purpose of locating a water right only and has no intent to provide legal dimensions or the location of property lines.

**ESTES SURVEYS**  
 6293 Sunnyview Rd. NE 60382 Arnold Rd.  
 Salem, OR 97305 Bend, OR 97702  
 (503) 585-7593 (503) 382-7391