


T.4S. R.1E. W.M.

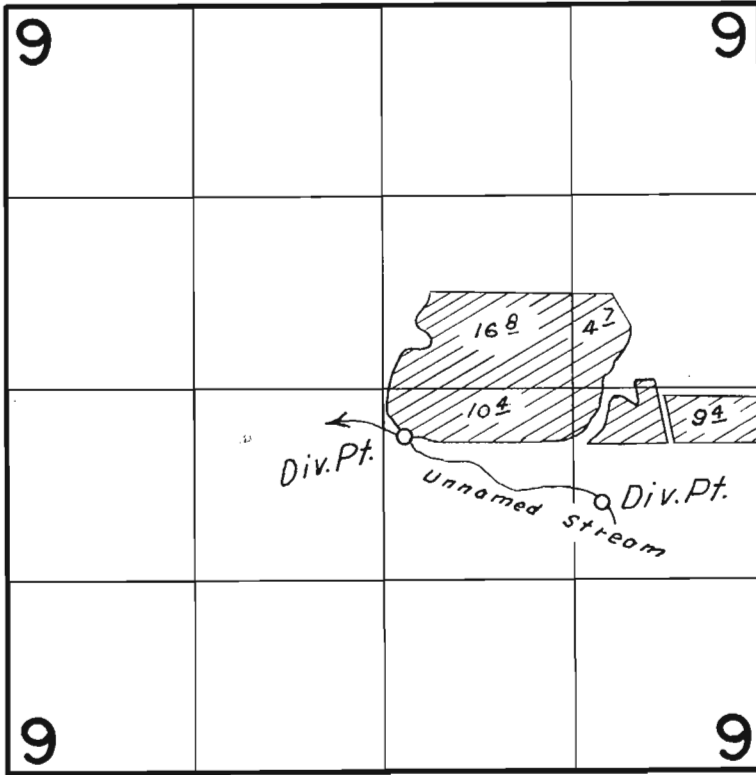

**FINAL PROOF SURVEY**  
UNDER

Application No. 33834... Permit No. 26682...  
IN NAME OF

**ANDREW M. HEIN**

Surveyed July 24, 1964, by C.J. Gardner...