


T. 2 N. R. 27 E. W. M.

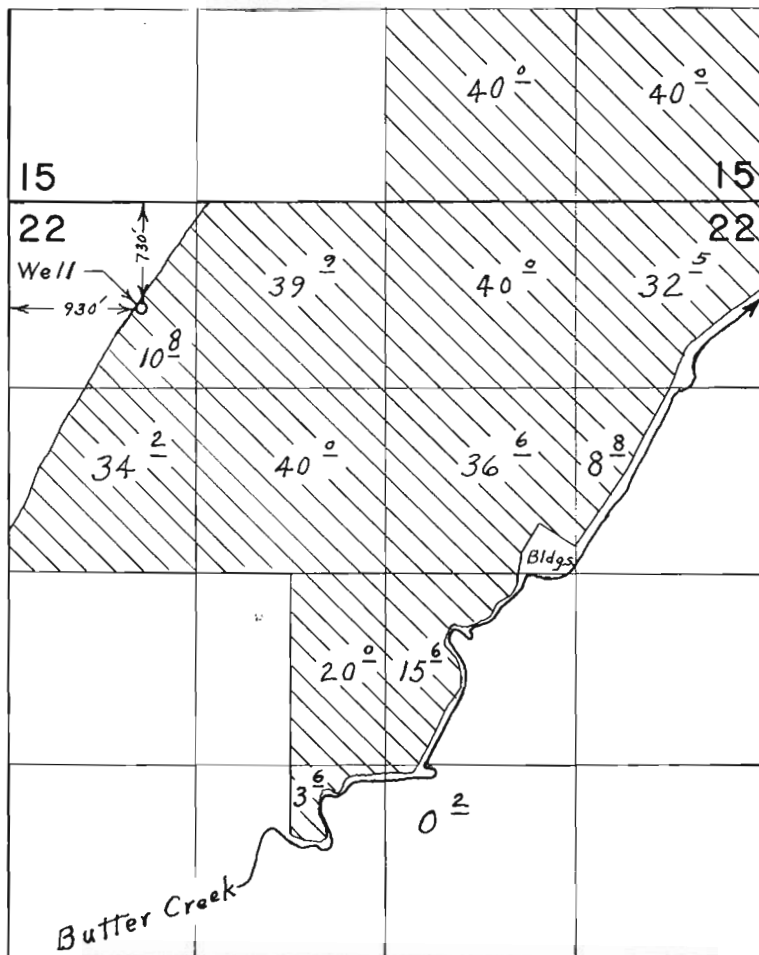

FINAL PROOF SURVEY
UNDER

Application No. G-37.72 Permit No. G-35.58
IN NAME OF

MICHAEL JOHN KILKENNY

Surveyed Nov. 3, 1971, by L. E. Gould