


T. 5 N. R. 26 E. W. M.

"To" lands

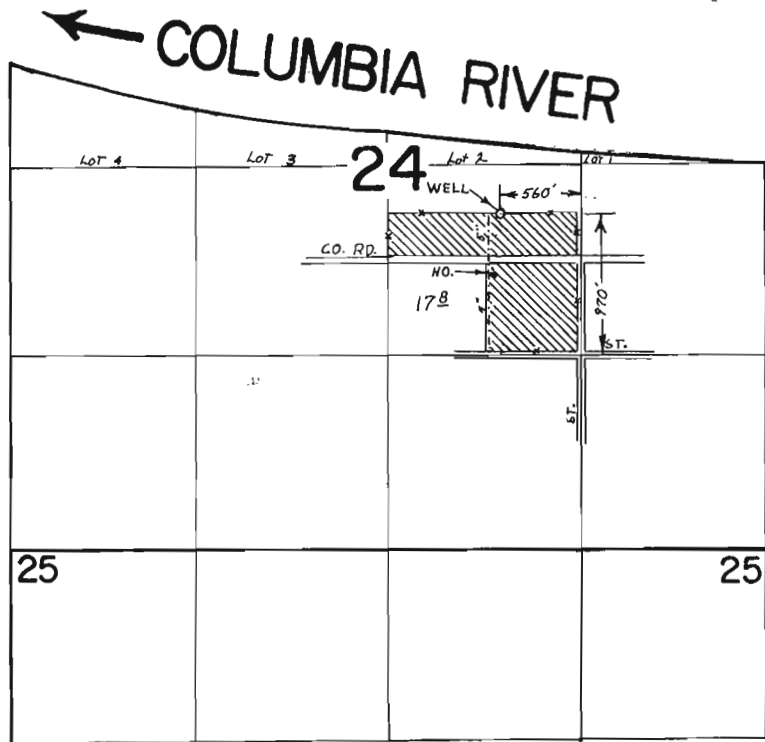

FINAL PROOF SURVEY
UNDER

Application No. G-4710 Permit No. G-4474
IN NAME OF

CHARLES J. & ESTHER E. SWIFT

Surveyed JULY 1, 1971, by R. MUCKEN