


T. 3N. R. 28E. W. M.

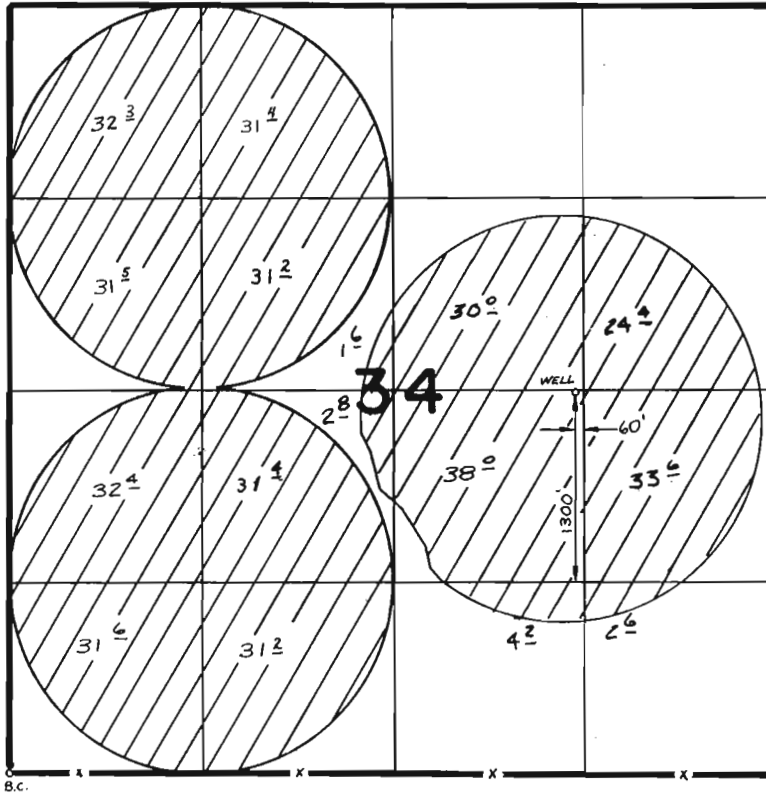

FINAL PROOF SURVEY
UNDER

RECEIVED

JUN 8 1982

WATER RESOURCES DEPT
SALEM OREGON

Application No. G-5820 Permit No. G-5812
IN NAME OF

David Sparks

Surveyed 4-30 1979, by R. BARWIN