

Scale: 1" = 200 ft.

New point of diversion is 1,110 ft.
South & 510 ft. West of the North
1/4 corner of Section 17.


Existing point of diversion is 1,370 ft.
South & 400 ft. West of the North
1/4 corner of Section 17.

**CLAIM OF BENEFICIAL USE OF A
WATER RIGHT TRANSFER, PERMIT NO. 33826,
in the NW 1/4 of Section 17, T26S, R4W, W.M.,
Douglas County, Oregon**

**Transfer No. 8165
Permit No 33862, App. No. 45306**

**For: Evan Sitton
2211 Whistlers Bend Park Road
Roseburg, Oregon 97470**

**By: Shaner Engineering, Inc.
P.O. Box 1430
Roseburg, Oregon 97470**

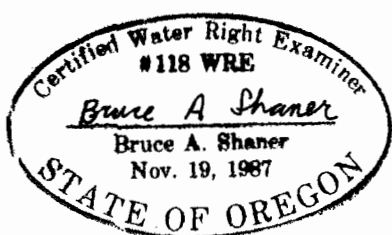

August 17, 2002