


FINAL PROOF SURVEY
DIVERSION POINTS

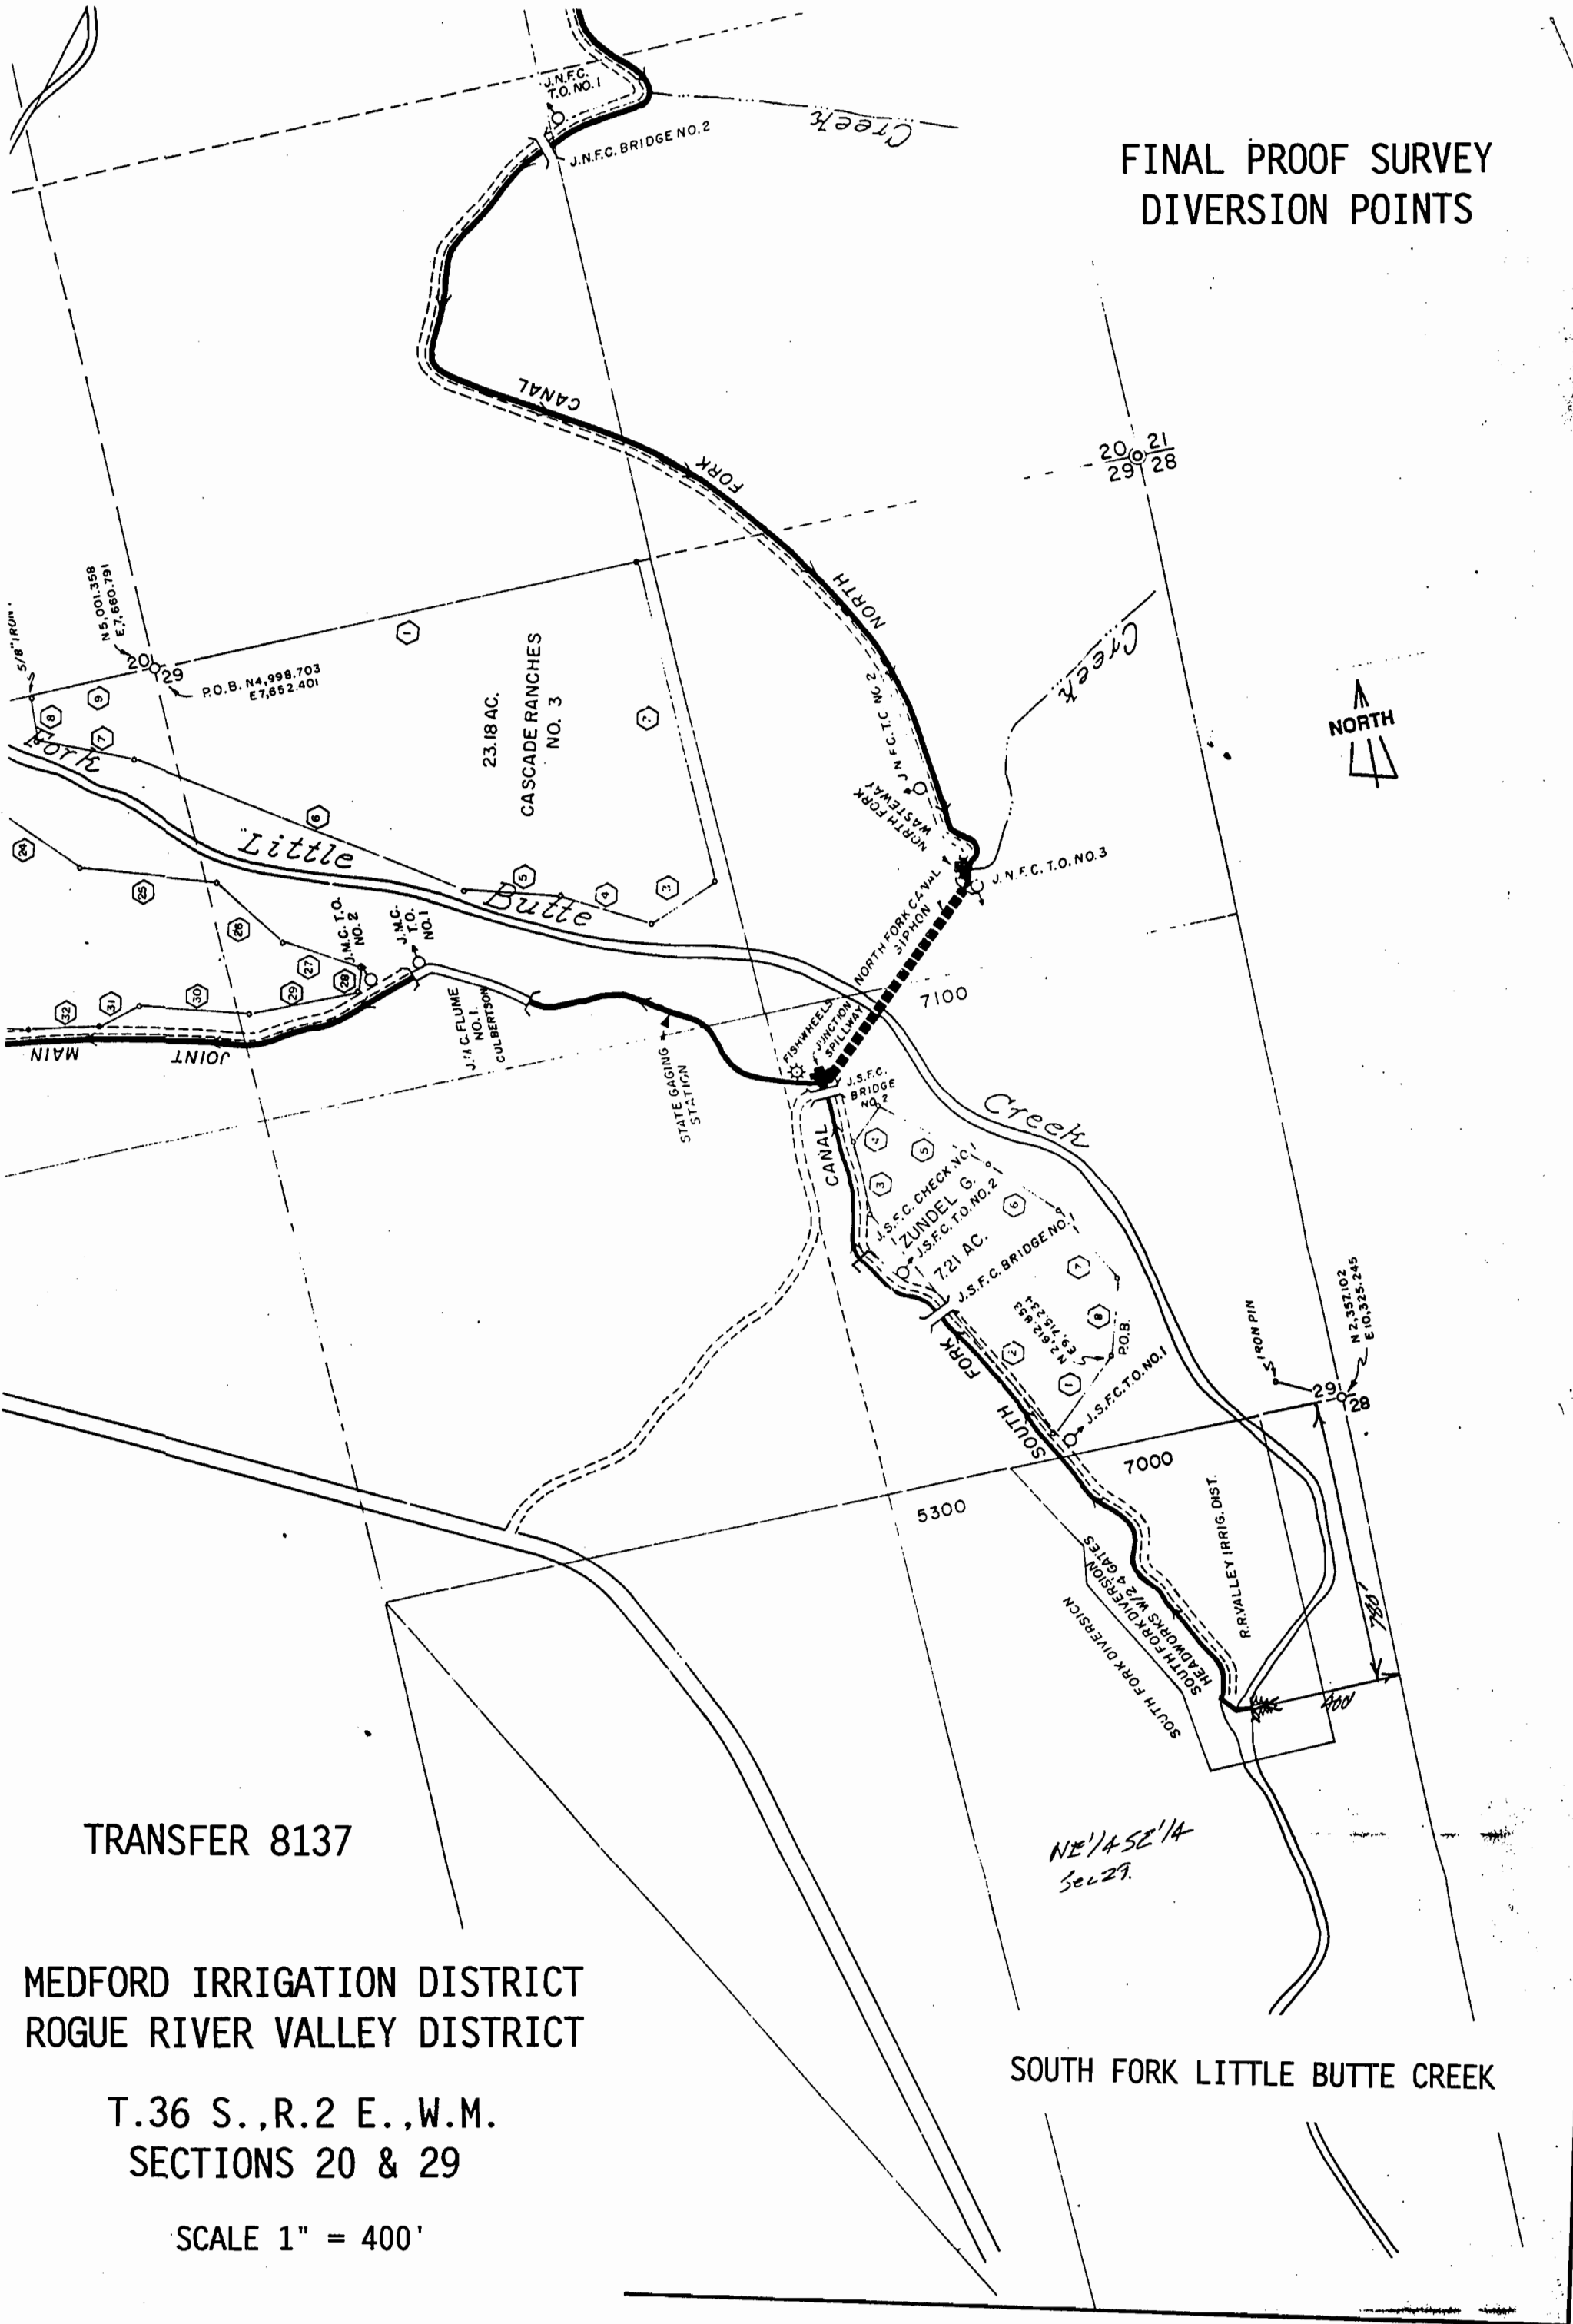

TRANSFER 8137

MEDFORD IRRIGATION DISTRICT
ROGUE RIVER VALLEY DISTRICT

T.36 S., R.2 E., W.M.
SECTIONS 20 & 29

SCALE 1" = 400'

SOUTH FORK LITTLE BUTTE CREEK

PERMIT E-19

PERMIT 407