


FINAL PROOF SURVEY

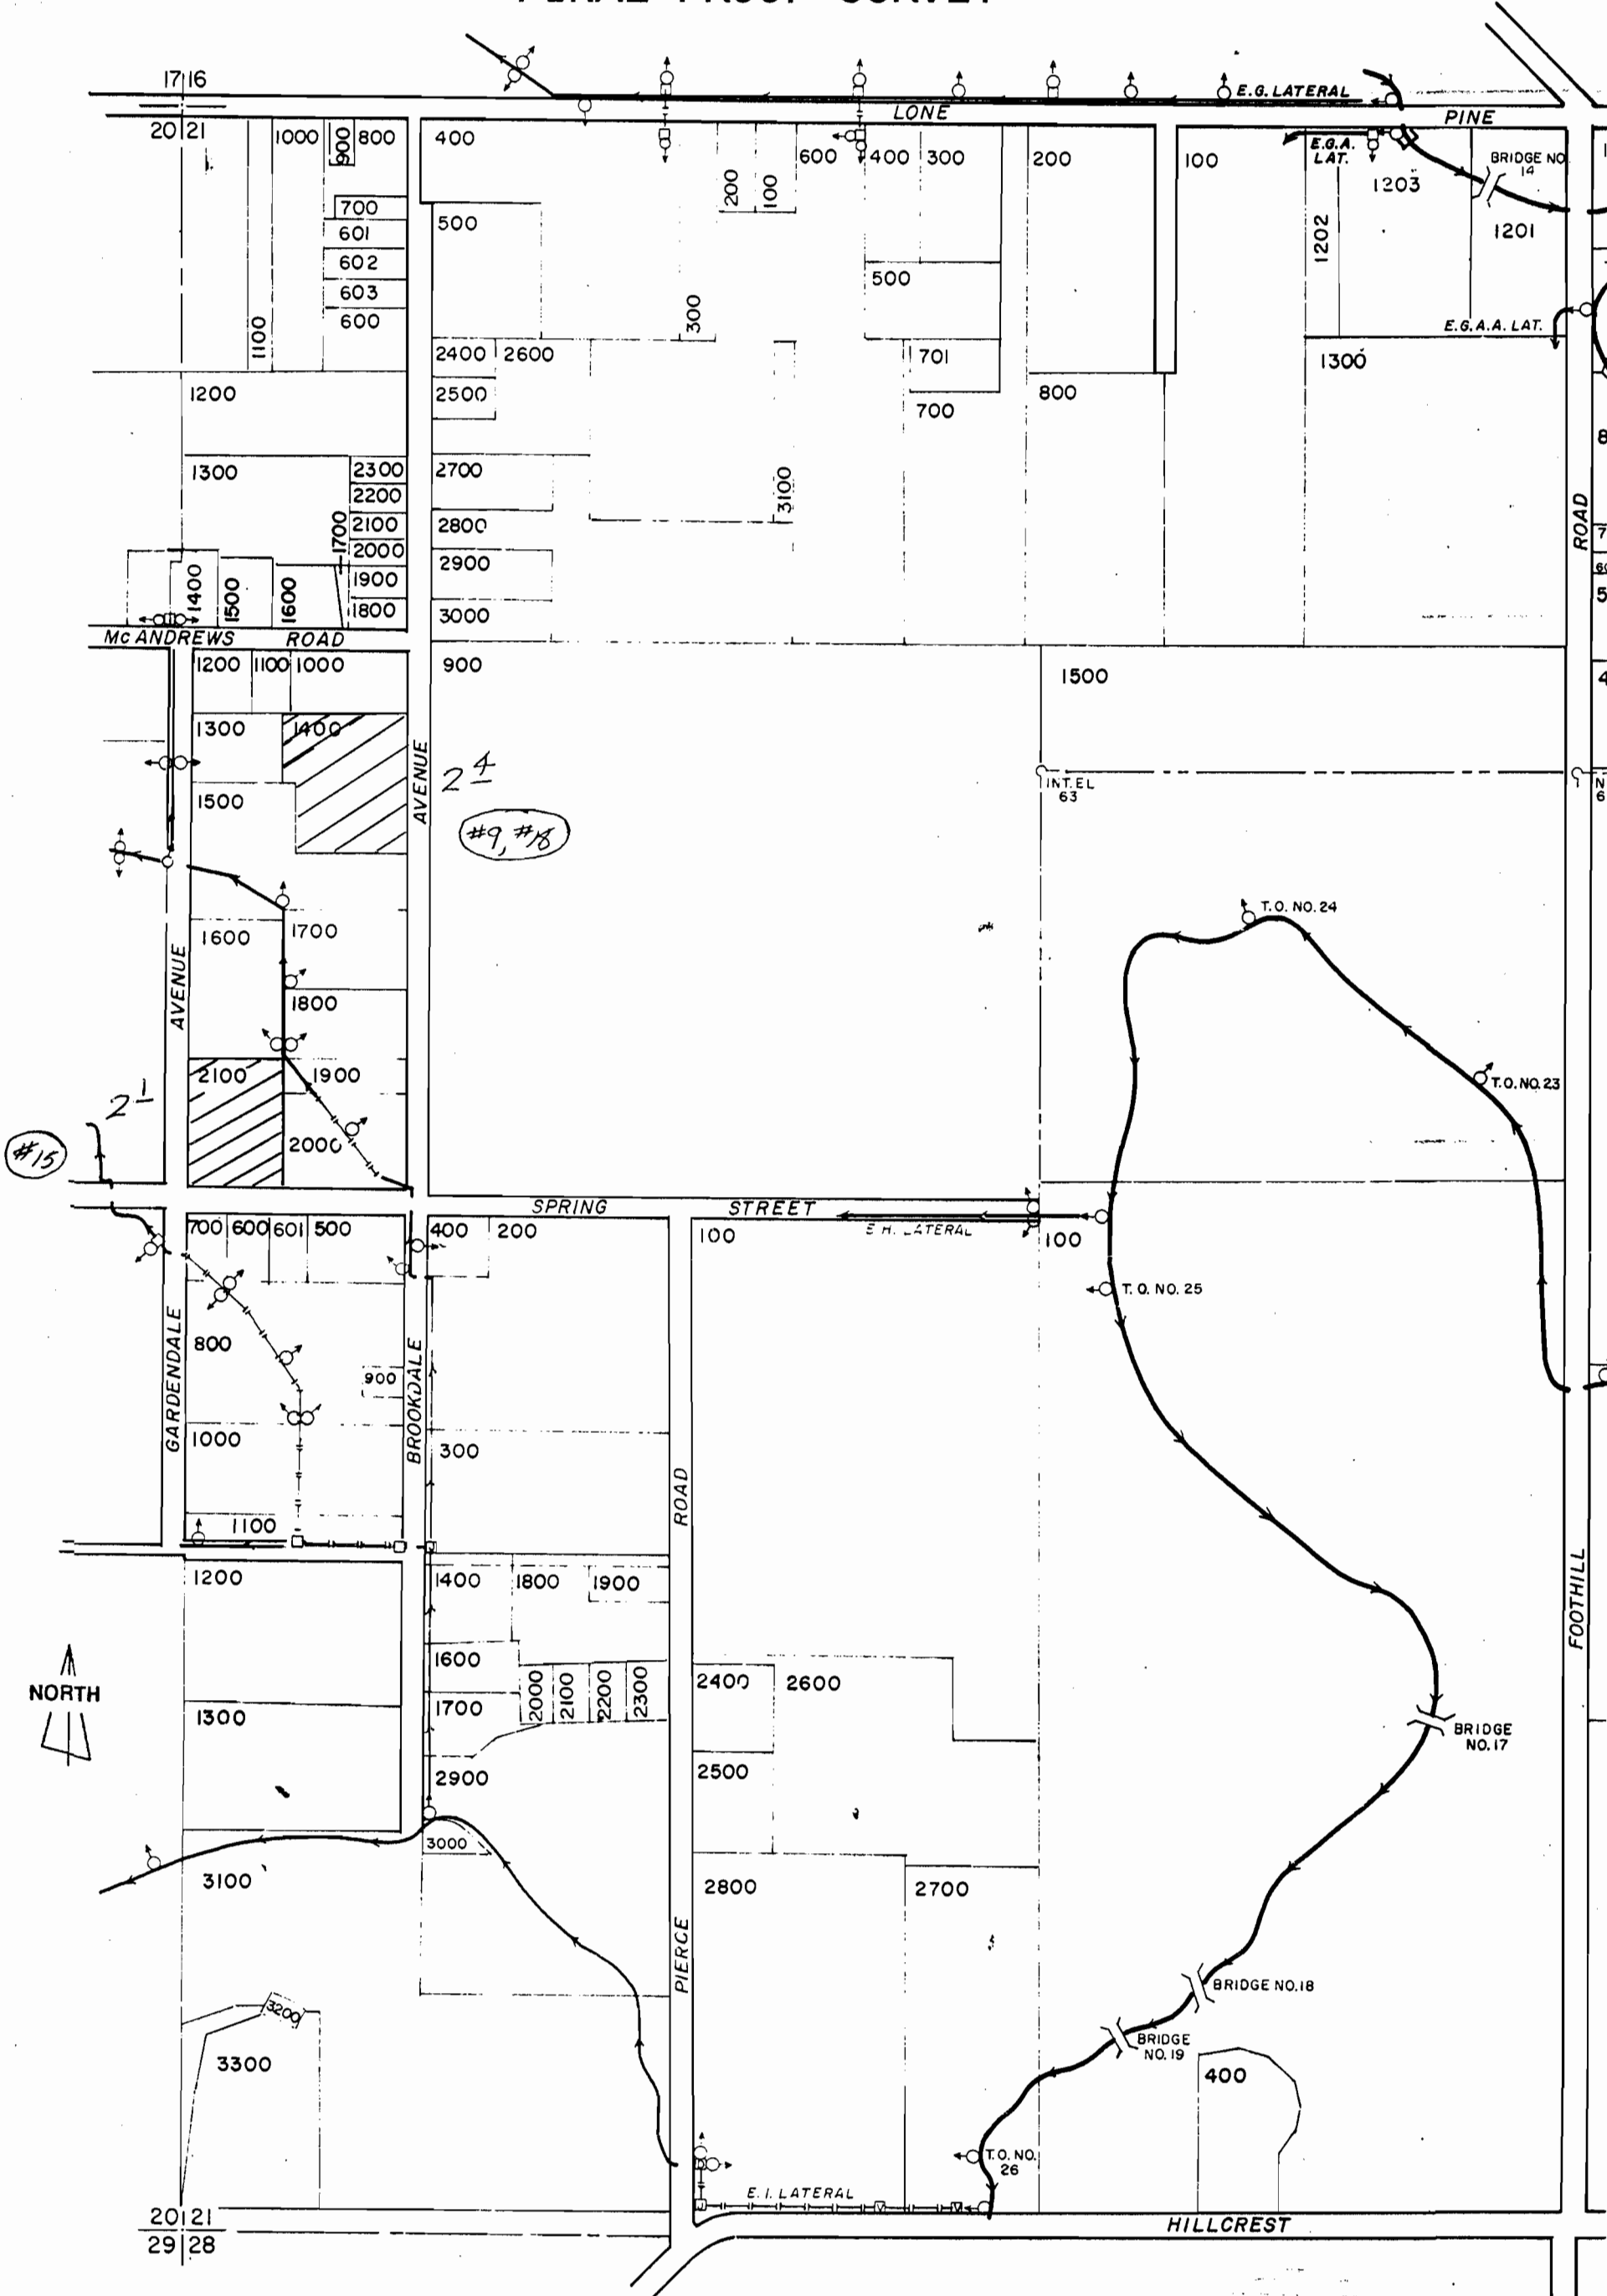

MEDFORD IRRIGATION DISTRICT

TRANSFER 8102

SECTION 21, T. 37 S., R. 1 W.

SURVEYED MARCH 6, 1997
MAY 21, 1997

D.L.C. 60, D.L.C. 61 & D.L.C. 63

by: S. DeHAAS

COMPILED BY J. A. HOFFBUHR, REG. L. S. MEDFORD, OREGON
SCALE 1" = 400'

SEPTEMBER, 1965

*drafted
2/65*