



T 2 N, R 11 E, W.M.  
SECTION 31

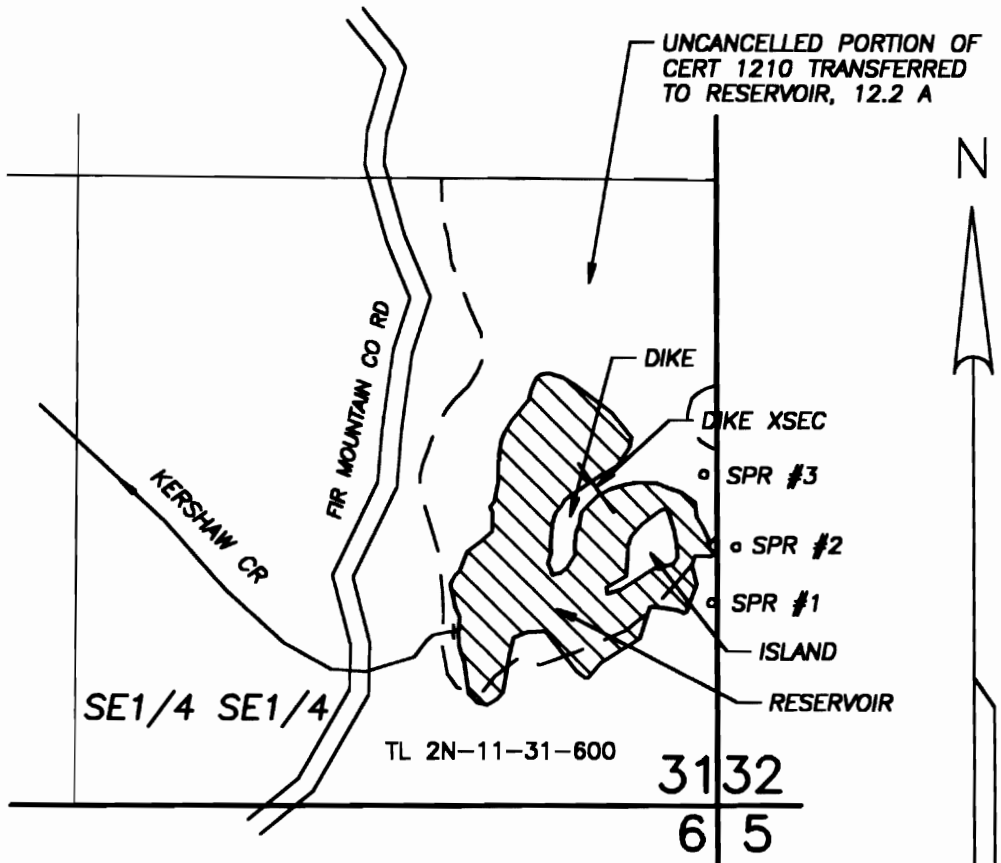

N

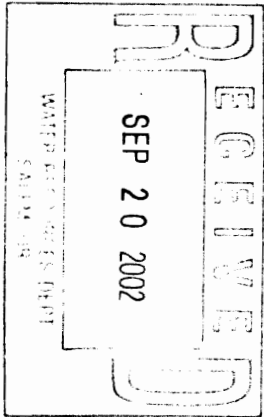

1" = 400'

- SPRING #1 - N 425' & W 10' from SE Cor S31
- SPRING #2 - N 540' & E 40' from SE Cor S31
- SPRING #3 - N 695' & W 27' from SE Cor S31

RESERVOIR AREA (MAX): 4.3 ACRES  
DEPTH (MAX) : 12.5 FEET  
CAPACITY (MAX): 9.4 AF


**CLAIM OF BENEFICIAL USE MAP**  
FOR  
**RICHARD STRACHAN**

APPLICATION S-80581  
APPLICATION R-80582  
TRANSFER

PERMIT 52905  
PERMIT R-12068  
T-7554

Prepared September 16, 2002  
PARSONS SURVEYING  
1915 S.E. Stone St.  
Corvallis, OR 97333  
(503) 752-7515  
Project No. 0225

This map is for location of Water Right only and does not constitute a boundary survey.

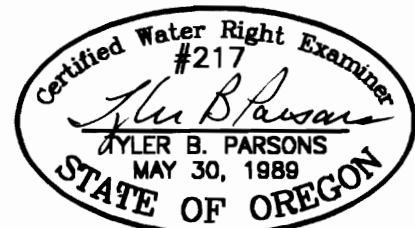

EXP: 12/31/2002