


T 5 N, R 29 E, W.M.
S 1/2 NW 1/4, SECTION 28

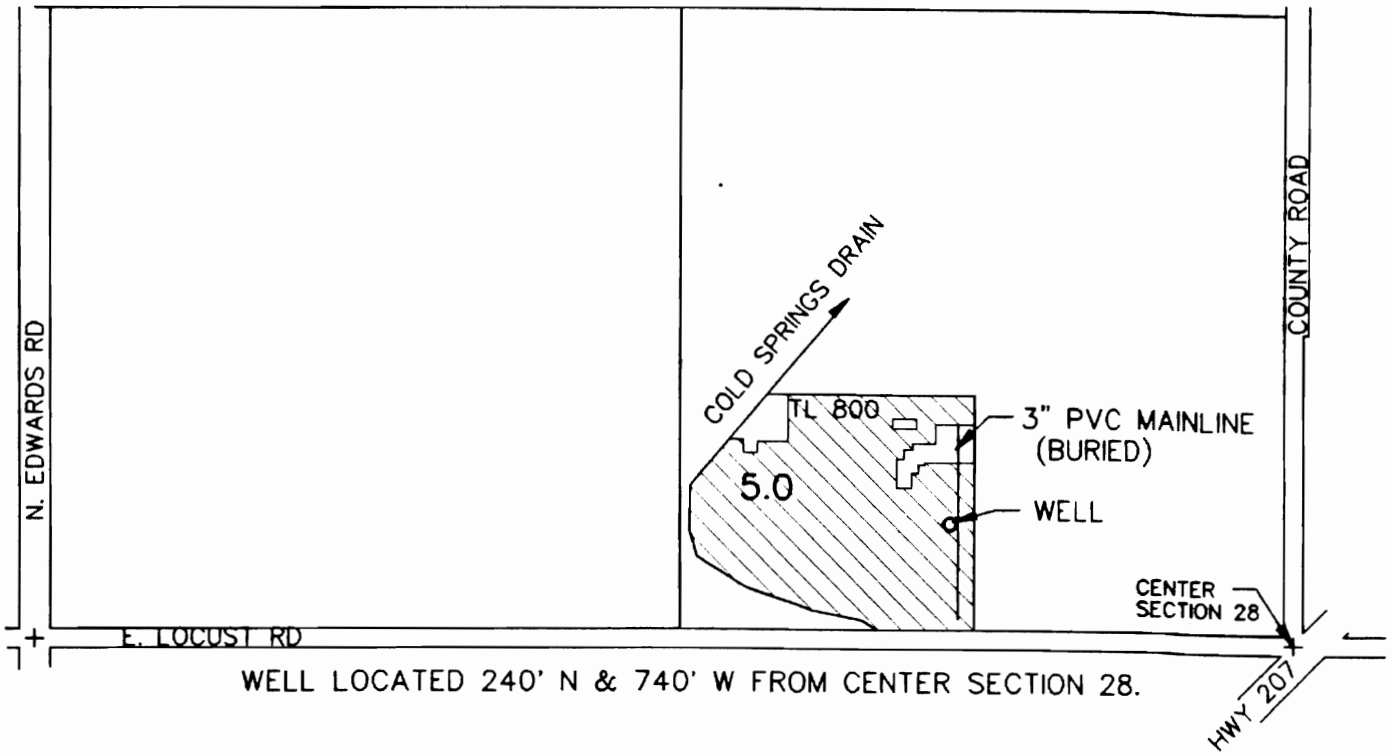

SCALE 1" = 400'

FINAL PROOF SURVEY

UNDER


T-7564

IN NAME OF

VIRGINIA M. BLADE



The preparation of this map is for the purpose of identifying the location of water rights only, and has no intent to provide dimensions or locations of property ownership lines.

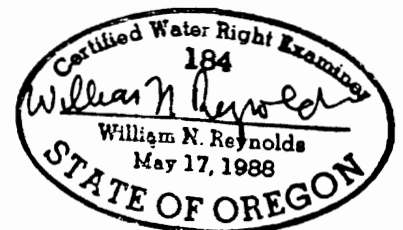

10/26/00