

RECEIVED

AUG 18 2003

WATER RESOURCES DEPT.
SALEM, OREGON

Map of Beneficial Use

under

Permit T-9111

in name of

PAUL HARCOMBE
30680 Horseshoe Dr. SW
Albany, OR 97321

Date of Site Inspection: August 12, 2003

Date of Map: August 14, 2003

Tax Lot: 800 (11-4W-22)

Source: Horseshoe Lake, a tributary of the Willamette River
and the Willamette
River Basin Project Reservoir

I, JACK R. BURRELL, BEING DULY SWORN AS A WATER RIGHT EXAMINER, LICENCE NO.209, HAVE PREPEARED THIS MAP FOR PAUL HARCOMBE ON THIS 14TH DAY OF AUGUST, 2003. THE AREAS HATCHED REPRESENT THE LAND'S BEING IRRIGATED UNDER THIS PERMIT.

PREPARATION OF THIS MAP IS FOR THE PURPOSE OF IDENTIFYING THE LOCATION OF THE WATER RIGHT ONLY AND HAS NO INTENT TO PROVIDE DEMESIONS OR LOCATION OF PROPERTY OWNERSHIP LINES.




NEW PLACE OF USE



AREA BEING TRANSFERRED




EXISTING WATER RIGHT CERTIFICATE #42198
AND RE-ISSUED AS #79962

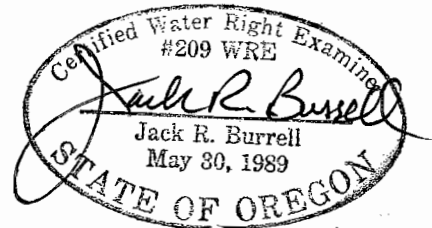

RENEWAL DATE 12/31/03

KD ENGINEERING, INC.
 273 N.W. HICKORY STREET
 POST OFFICE BOX 725
 ALBANY, OREGON 97321

J. MOORE
D.L.C. 59

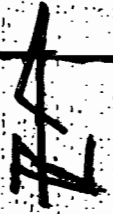

Scale:
1" = 400'

RECEIVED

AUG 18 2003

WATER RESOURCES DEPT.
SALEM, OREGON

D.L.C. 58

1480'

Lake

4.0 acres
NEW PLACE
OF USE

W. MOORE
D.L.C. 6

16 15

HORSESHOE LANE

21

NW 1/4 NW 1/4 Sec.22

NE 1/4 NW 1/4 Sec.22
HARCOMBE
PROPERTY

NW 1/4 Sec.22

1.7 acres to
be transferred

Proposed 5"
Pipe

2.3 acres to
be transferred

HORSESHOE
LAKE

Div.
Pt.

Existing 5"
Pipe

EXISTING WATER
RIGHT:

Permit # 34633

Certificate # 42198

SW 1/4 NW 1/4 Sec.22

SE 1/4 NW 1/4 Sec.22

22