


T.18&2S. R.39E. W.M.

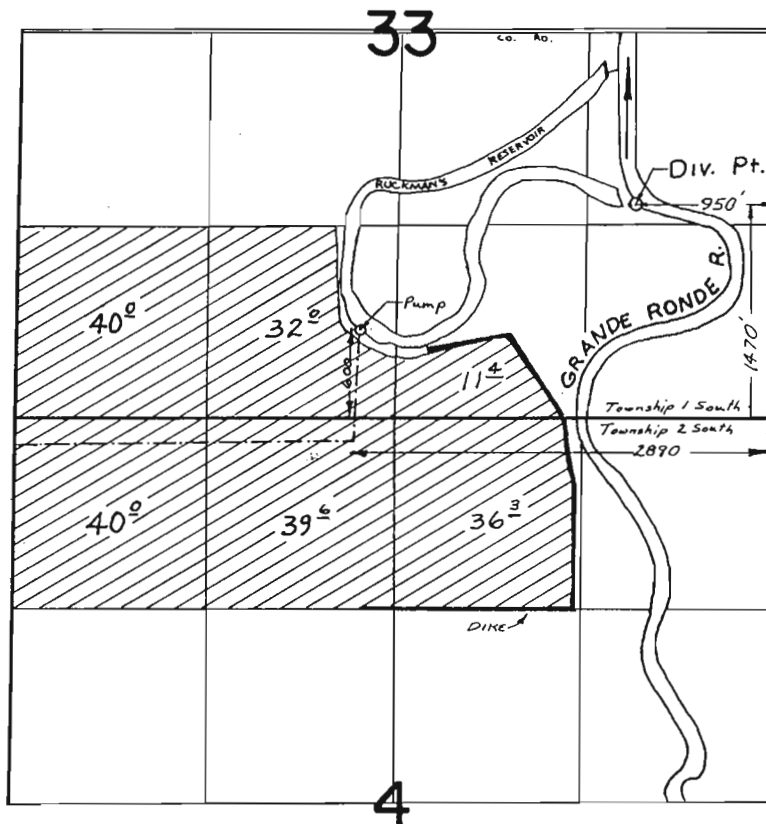

FINAL PROOF SURVEY
UNDER

38857 29200
Application No. R-38856 Permit No. R-3883
IN NAME OF

GAIL TALBOTT

Surveyed JULY 16, 1973, by R. G. MUCKEN