


# FINAL PROOF MAP OF TRANSFER T-7577 FOR WILSON DITCH COMPANY

T3N, R230E WM

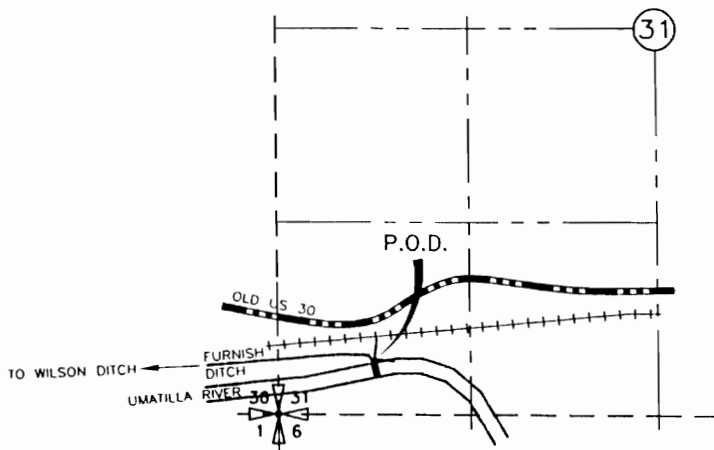


### ADDITIONAL P.O.D. FURNISH DITCH

P.O.D. FURNISH DITCH  
LOCATED 380' NORTH AND 650' EAST  
FROM THE SW CORNER SEC 31

RECEIVED

DALE G. VAN SCHOLACK

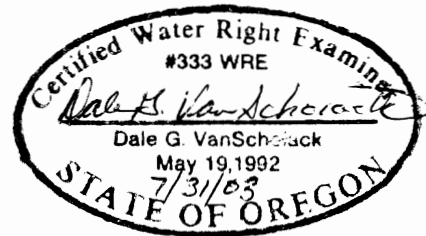

7/30/03

NOTE:  
THE PURPOSE OF THIS MAP IS TO IDENTIFY THE APPROXIMATE LOCATION  
OF THE WATER RIGHT. IT IS NOT INTENDED TO PROVIDE INFORMATION  
RELATIVE TO THE LOCATION OF PROPERTY OWNERSHIP BOUNDARY LINES.