


**FINAL PROOF SURVEY OF A
WATER RIGHT TRANSFER, PERMIT NO. 40557,
TO LOT 25 OF WHISTLERS PARK ESTATES
IN LOT 5, SECTION 17, T26S, R4W, W.M.,
DOUGLAS COUNTY, OREGON**

Transfer No. 7591

Permit No. 40557

For: Ericson 1996 Revocable Living Trust
c/o Carl Olof Ericson & Lis Ericson
P.O. Box 55
Glide, Oregon 97443

By: Shaner Engineering, Inc.
P.O. Box 1430
Roseburg, Oregon 97470

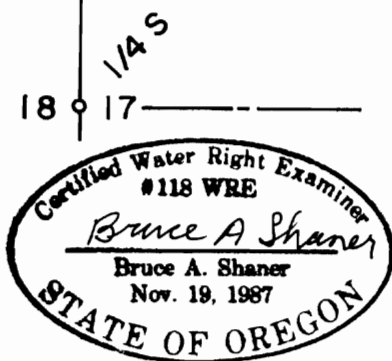

July 9, 1999